


KANSAS

Phillips

Section 31 Township 5 Range 20W

Well No. 13 Pinkerton

Company Cities Service

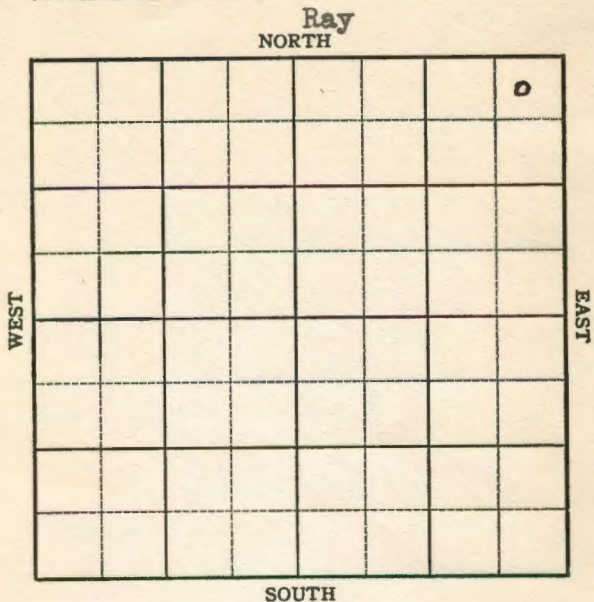

KANSAS

Phillips

Sec. 31 Twp. 5 R. 20W

Well No. #13 Pinkerton Farm

Cities Service Company

Ray Pool


330' Ft. from N. Line

_____ Ft. from S. Line

330' Ft. from E. Line

_____ Ft. from W. Line

NE/C

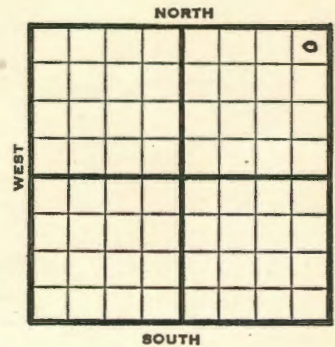

1949 **Elev 2229'** REPORT

3/9 8" @ 211'
 Drlg. 2802'

3/16 **Lansing 3388'**
Reagan 3638-43'
 TD 3643'
 5" @ 3639'

3/23 "

3/29 Pump 209 bbls oil 10 hrs.

4/6 TD 3643'
Reagan 3638'
 5" @ 3639'
 Depth Pot 3000
 30° Gr.
 Comp

COMPLETED

Map No. 133 Sec. 31 Twp. 5 R. 20W

Well No. 13 Pinkerton

Cities Service Company

COMPLETE Contractor

NE/C

E 12229
SECTION PLAT

330 Ft. from N. Line

_____ Ft. from S. Line

330 Ft. from E. Line

_____ Ft. from W. Line

Phillips County

Location _____

Rig up _____

Drilling and Remarks:

Reagan 3638
Sec 36 38
Dr. W. P. 43000

RECORD

Cased _____ in., _____ ft.

Sand _____

Gas _____

Oil _____

Total Depth 3649

PRODUCTION

1st 24 hrs. Nat. _____

1st 24 hrs. after shot _____

Gas _____ Cu. Ft.

Dry Hole _____

Abandoned _____

Date

APR 6 1949

S. J. LEWIS Scout

Map No. _____ Sec. 31 Twp. 5 R. 20W

Well No. 13 Pinkerton

Cities Service Company

FIRST REPORT Contractor

NE/C

SECTION PLAT

330 Ft. from N. Line

_____ Ft. from S. Line

330 Ft. from E. Line

_____ Ft. from W. Line

Phillips County

Location _____

Rig up _____

Drilling and Remarks:

8" @ 211
drlg. 2802

RECORD

Cased _____ in., _____ ft.

Sand _____

Gas _____

Oil _____

Total Depth _____

PRODUCTION

1st 24 hrs. Nat. _____

1st 24 hrs. after shot _____

Gas _____ Cu. Ft.

Dry Hole _____

Abandoned _____

Date

MAR 9 1949

S. J. LEWIS Scout