

KANSAS


Phillips

Section 31 Township 5 Range 20W

Well No. 4 Solt

Company Cities Service

Ray Pool
NORTH

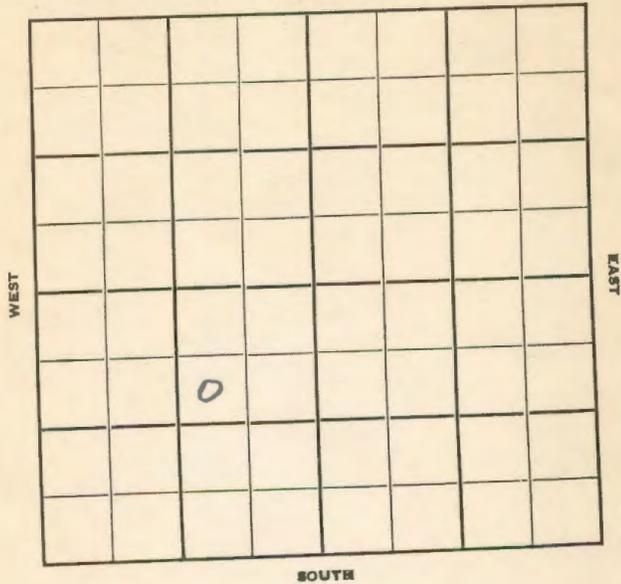

KANSAS

Phillips

Sec. 31 Twp. 5 R. 20W

Well No. 4 Solt Farm _____

Cities Service Company _____

Ray Pool Rine Drlg. -Contr.


990 Ft. from N. Line

_____ Ft. from S. Line

990 Ft. from E. Line

_____ Ft. from W. Line

SW NE SW

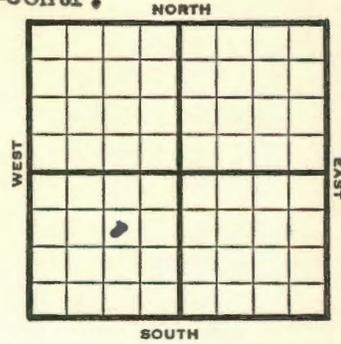

1949 **Elev 2213'** REPORT

- 9/28 8" @ 285'
Drlg. 1375
- 10/5 Drlg 3425'
- 10/12 **Lansing 3388'**
Reagan 3627'
5" @ 3628'
TD 3634'
Pump 302 oil 24 hrs.
- 10/19 "
- 10/26 "
- 11/1 "
- 11/9 TD 3634'
Reagan 3627'
5" @ 3628'
Pump 336 Oil Pot
30° Gr.
Comp

COMPLETED

Ray Pool

Map No. _____ Sec. 31 Twp. 5 R. 20W

Well No. 4 Solt

Cities Service _____ Company

COMPLETE

Contractor

SW NE SW

E. 2213
SECTION PLAT

990 Ft. from N. Line
_____ Ft. from S. Line
990 Ft. from E. Line
_____ Ft. from W. Line

Phillips County

Location _____

Rig up _____

Drilling and Remarks:

Reagan 3627
5-23-48
Prod. 336 oil Pt
20-4

RECORD

Cased _____ in., _____ ft.
Sand _____
Gas _____
Oil _____
Total Depth *2634*

PRODUCTION

1st 24 hrs. Nat. _____
1st 24 hrs. after shot _____
Gas _____ Cu. Ft.
Dry Hole _____
Abandoned _____

Date

NOV 9 1949 19 S. J. LEWIS Scout

Ray Pool

Map No. _____ Sec. 31 Twp. 5 R. 20W

Well No. 4 Solt

Cities Service _____ Company

Rine Drlg.

Contractor

SW NE SW

FIRST REPORT
SECTION PLAT

990 Ft. from N. Line
_____ Ft. from S. Line
990 Ft. from E. Line
_____ Ft. from W. Line

Phillips County

Location _____

Rig up _____

Drilling and Remarks:

8" @ 285
drlg. 1375

RECORD

Cased _____ in., _____ ft.
Sand _____
Gas _____
Oil _____
Total Depth _____

PRODUCTION

1st 24 hrs. Nat. _____
1st 24 hrs. after shot _____
Gas _____ Cu. Ft.
Dry Hole _____
Abandoned _____

Date

SEP 28 1949 19 S. J. LEWIS Scout