

KANSAS

FORM 51 5M 10-41 PETROL

Phillips

Form 252-A
5M 5-42 Petrol

KANSAS

Phillips

20-W
~~20-E~~

Sec. 31 Twp. 5 R. 20-W

Well No. #3 Veeh Farm _____

Cities Service Oil Company _____

(Ray Pool)


Section 31 Township 5 Range 20-W

Well No. #3 Veeh

Company Cities Service Oil


Ray Pool

NORTH

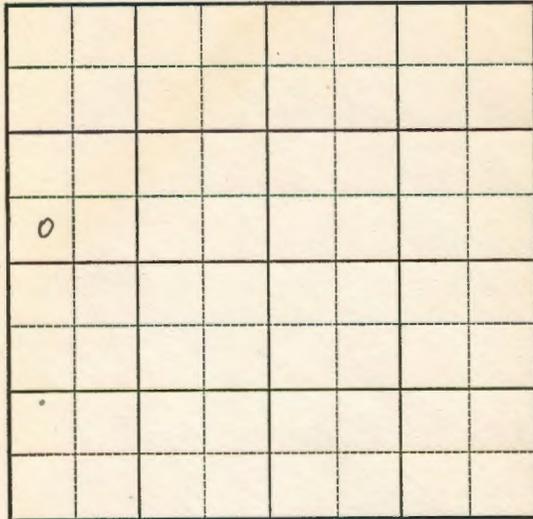

SOUTH

5

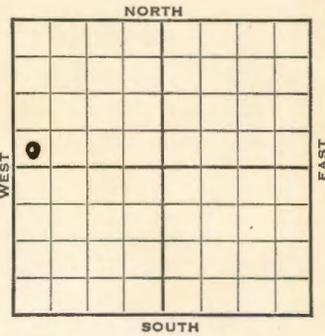

_____ Ft. from N. Line

330 Ft. from S. Line

_____ Ft. from E. Line

330 Ft. from W. Line

Elev. 2228

REPORT

1942

9/2 8" - 155' Waiting on cement.

9/9 Drlg 3170

9/16 Reagan 3642 Granite 3679
T.D. 3681 5" @ 3681
12 shots 2646-50, 12 shots
3642-46 1200' oil in 3 hrs.

9/23 Taking Potential

9/30 Reagan Sd. 3642
Granite 3679
5" 3681
T.D. 3681
Perf. 3646-50 - 12
" 3640-50 - 11
Phy. pot. 371 oil 15 wtr.
35 grav.

COMPLETED

Phillips

Map No. 133 Sec. 31 Twp. 5 R. 20W

Well No. 3 Veeh

Cities Service Oil Company

CORRECTION Contractor

SW NW

SECTION PLAT

_____ Ft. from N. Line

330 Ft. from S. Line

_____ Ft. from E. Line

330 Ft. from W. Line

RAY POOL

Location _____

Rig up _____

Drilling and Remarks:

Reported

31-5-20E

RECORD

Cased _____ in., _____ ft.

Sand _____

Gas _____

Oil _____

Total Depth _____

PRODUCTION

1st 24 hrs. Nat. _____

1st 24 hrs. after shot _____

Gas _____ Cu. Ft.

Dry Hole _____

Abandoned _____

Date

SEP 2 1942 19

S. J. LEWIS Scout

Phillips

Map No. _____ Sec. 31 Twp. 5 R. 20E

Well No. 3 Veeh

Cities Service Oil Company

FIRST REPORT Contractor

SW NW

SECTION PLAT

_____ Ft. from N. Line

330 Ft. from S. Line

_____ Ft. from E. Line

330 Ft. from W. Line

RAY POOL

Location _____

Rig up _____

Drilling and Remarks:

8"-155'

Waiting on cement

RECORD

Cased _____ in., _____ ft.

Sand _____

Gas _____

Oil _____

Total Depth _____

PRODUCTION

1st 24 hrs. Nat. _____

1st 24 hrs. after shot _____

Gas _____ Cu. Ft.

Dry Hole _____

Abandoned _____

Date

SEP 2 1942 19

S. J. LEWIS Scout

KANSAS

Phillips

Map No. 133 Sec. 31 Twp. 5 R. 20W

Well No. 3 Veeh

Cities Service Oil Company

Contractor

SW NW

SECTION PLAT

Ft. from N. Line

330 Ft. from S. Line

Ft. from E. Line

330 Ft. from W. Line

RAY POOL

Location _____

Rig up _____

Drilling and Remarks:

Perf 3646-50-12
" 3640-50-11

Phy Pot
371 oil
15 Wtr

RECORD

Cased 5 in., 3681 ft.

Sand _____

Gas _____

Oil _____

Total Depth 3681

PRODUCTION

1st 24 hrs. Nat. _____

1st 24 hrs. after shot _____

Gas _____ Cu. Ft.

Dry Hole _____

Abandoned _____

Date 35 gdr
COMPLETED

SEP 30 1942 19 S. I. LEWIS Scout

Reagan Rd 3642 568039
Granite 3679










Ray
←
X

DATE COMPLETED
