

KANSAS

Form 51-5M-7-40-Palace


Phillips

Section 32 Township 5 Range 20-W

Well No. #1 Ray

Company Harbar Drilling

NORTH Wildcat

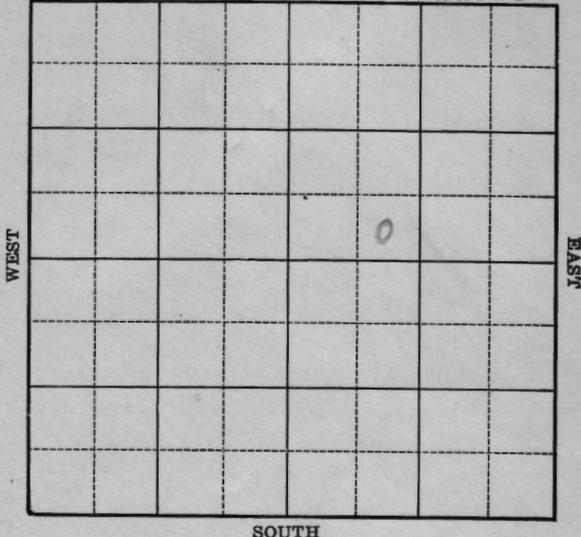

SOUTH

10

Sec. 32 Twp. 5 R. 20-W

Well No. #1 Ray Farm _____

Harbar Drilling Company
(Wildcat)


_____ Ft. from N. Line

330 Ft. from S. Line

_____ Ft. from E. Line

990 Ft. from W. Line

Elev. 2187

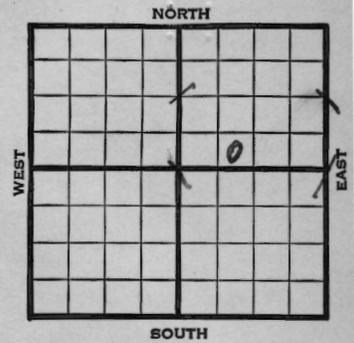

1940	REPORT
9/18	Rotary.
9/26	10" - 121' Anhø 1705' Drlg. 2700'
10/3	Topeka 3120' SO 3320-30' SO 3370-71' Lans. 3394' SO BKC 3540' Drlg. 3567'
10/10	Basal sand 3578' Base Sand 3612' Granite wash 3627' T.D. 3634' Good show oil.in Basal. 5" - 3615' RUST
10/17	Bailing mud.
10/24	3 shots 3603' 3 shots 3604 1687' fluid 1 hour, 20% water. P.B. 3597' 11 shots 3593-97 2500' fluid, 40% water. P.B. 3605' Swab 40 bbls. per hour and 4% water 1800' off btm
	OVER

1940

10/30

Basal sand 3578'

5" - 3615'

T.D. 3634'

P.B. to 3602'

11 shots 3593-97'

59 shots 3573-3602'

Echometer potential 3474 bbls.

Maximum 3000 bbls.

COMPLETED

Map No. 133 Sec. 32 Twp. 5 R. 20W

Well No. 1 Ray

Harbar Drilling Company
Contractor

FIRST REPORT
SE SW NE

SECTION PLAT

_____ Ft. from N. Line
330 Ft. from S. Line
_____ Ft. from E. Line
990 Ft. from W. Line

WILDCAT

Location _____

RECORD

Rig up _____
Drilling and Remarks:

Rotary

Cased _____ in., _____ ft.
Sand _____
Gas _____
Oil _____
Total Depth _____

PRODUCTION

1st 24 hrs. Nat. _____
1st 24 hrs. after shot _____
Gas _____ Cu. Ft.
Dry Hole _____
Abandoned _____

Date

SEP 18 1940 19

S. J. LEWIS Scout

Map No. 133 Sec. 32 Twp. 5 R. 20W

Well No. 1 Ray

Harbar Drilling Company
Contractor

COMPLETED

SE SW NE

SECTION PLAT

_____ Ft. from N. Line
330 Ft. from S. Line
_____ Ft. from E. Line
990 Ft. from W. Line

WILDCAT

Location _____

RECORD

Rig up _____
Drilling and Remarks:

Base land 3578.
5" @ 3615.
PB 3602.
11 Sh. Y. 3098-97
59 " 3528-3602
Ech. P. Y. 3474
Nov 3000

Cased _____ in., _____ ft.
Sand _____
Gas _____
Oil _____
Total Depth 3634

PRODUCTION

1st 24 hrs. Nat. _____
1st 24 hrs. after shot _____
Gas _____ Cu. Ft.
Dry Hole _____
Abandoned _____

Date

OCT 30 1940 19

S. J. LEWIS Scout