


Section 32 Township 5 Range 20 W

Well No. # 7 Ray "A"

Company Cities Service Oil

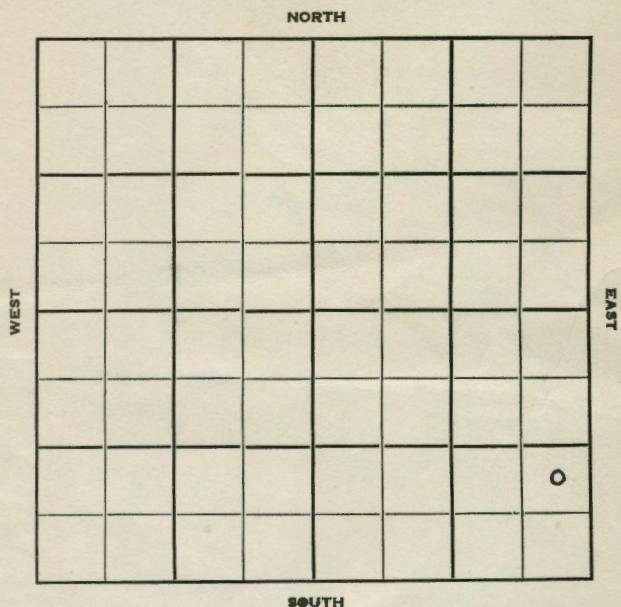

16

Sec. 32 Twp. 5 R. 20W

Well No. #7 Ray "A" Farm \_\_\_\_\_

Cities Service Oil Company \_\_\_\_\_

Rine Drlg. Contractor \_\_\_\_\_

Ray Pool


\_\_\_\_\_ Ft. from N. Line

990 Ft. from S. Line

330 Ft. from E. Line

\_\_\_\_\_ Ft. from W. Line

NE SE SE

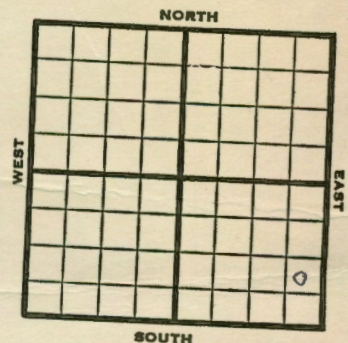

1951 **Elev. 2175'** REPORT

10/3 Spud 9-27-51  
8" @ 198

Drlg. 3125

12/5 Spud 9-27-51  
Oil Well TD 3567  
8" @ 198

Dodge 3303 KC 3331 Li 3563-67

5 1/2" @ 3564 TD 3567

FU 2319' oil 17 hr.

P/ 120 BOPD  
Comp. 123 BOPD

**COMPLETED**

