KANSAS


Form 51—5M—7-40—Palace

Phillips

Section 32 Township 5 Range 20W

Well No. #2 Johnson "B"

Company Cities Service Oil

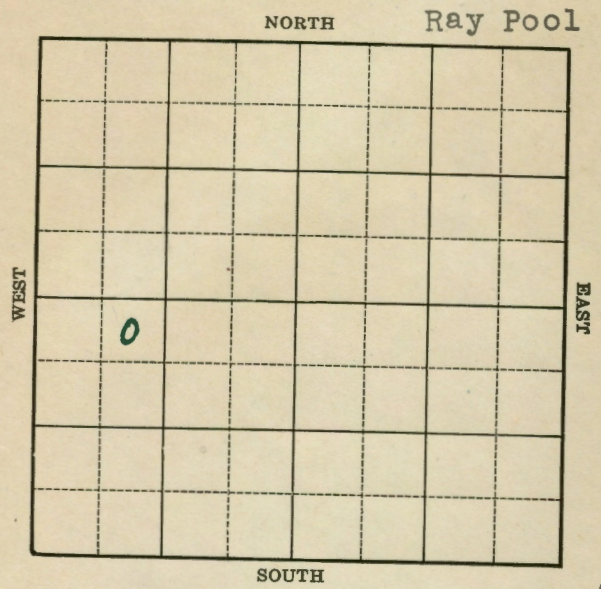

12

FORM 252-A 5M 1-41 PETROL KANSAS Phillips

Sec. 32 Twp. 5 R. 20-W

Well No. #2 Johnson "B" Farm

Cities Service Oil Company


(Ray)

330 Ft. from N. Line

_____ Ft. from S. Line

_____ Ft. from E. Line

990 Ft. from W. Line

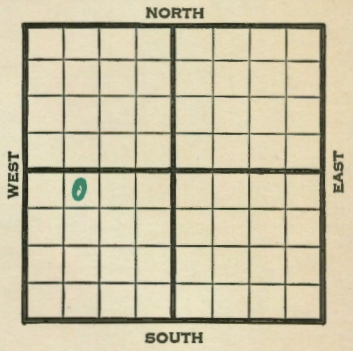

Elev. 2202

1941	REPORT
5/14	Location
5/22	"
5/28	10" - 175' WOC.
6/5	Drlg. 3270'
6/12	Reagan 3603'. B. Sand 3625'
	Granite 3635' T.D. 3636'
	5" - 3636' RUST.
6/19	" " "
6/26	94 shots 3598-3320' 2000 acid.
	Echometer potential 3000 bbls.
7/1	Reagan 3603'
	Granite 3635'
	5" - 3636'
	T.D. 3636'
	94 shots 3598-3320' in Lans.
	2000 acid.
	Echometer potential 3100 bbls.
	Maximum 3000 bbls.
	33. Gravity
	COMPLETED

Form 26 200 Bks. 5-41 McW. Phillips KANSAS

Map No. 133 Sec. 32 Twp. 5 R. 20W

Well No. 2 Johnson "B"

Cities Service Oil Company

COMPLETED Contractor

NE NW SW

330 Ft. from N. Line


____ Ft. from S. Line

____ Ft. from E. Line

990 Ft. from W. Line

RAY POOL

SECTION PLAT

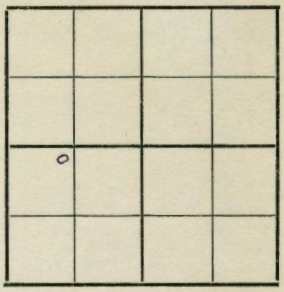

Location ____

Rig up ____

Drilling and Remarks:

Reagan 3603
Granite 3635
5½ @ 8636
94 Shots 3558-3320
2000 gal
Ecto BJ 3100
Mox 3000
33° Gr

RECORD

Cased ____ in., ____ ft.

Sand ____

Gas ____

Oil ____

Total Depth 8636

PRODUCTION

~~1st 24 hrs.~~ Nat. ____

1st 24 hrs. after shot ____

Gas ____ Cu. Ft.

Dry Hole ____

Abandoned ____

Date

JUL 1 1941 19

S. J. LEWIS Scout

Form 26—200 Bks.—1-40—Palace Phillips KANSAS

Map No. 133 Sec. 32 Twp. 5 R. 20W

Well No. 2 Johnson "B"

Cities Service Oil Company

FIRST REPORT Contractor

NE NW SW

330 Ft. from N. Line


____ Ft. from S. Line

____ Ft. from E. Line

990 Ft. from W. Line

RAY POOL

SECTION PLAT

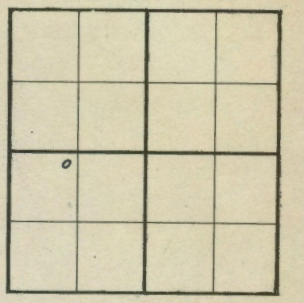

Location ____

Rig up ____

Drilling and Remarks:

Location

RECORD

Cased ____ in., ____ ft.

Sand ____

Gas ____

Oil ____

Total Depth ____

PRODUCTION

1st 24 hrs. Nat. ____

1st 24 hrs. after shot ____

Gas ____ Cu. Ft.

Dry Hole ____

Abandoned ____

Date

~~MAY~~ 14 1941 19

S. J. LEWIS Scout