

KANSAS
Phillips

FORM 51 5M 10-41 PETROL

Sec. 32 Twp. 5 R. 20-W

Well No. #5 Johnson "B" Farm _____

Cities Service Oil Company

Section 32 Township 5 Range 20-W

Well No. #5 Johnson "B"

Company Cities Service Oil

(Ray)



990 Ft. from N. Line

_____ Ft. from S. Line

_____ Ft. from E. Line

330 Ft. from W. Line

Elev. 2170

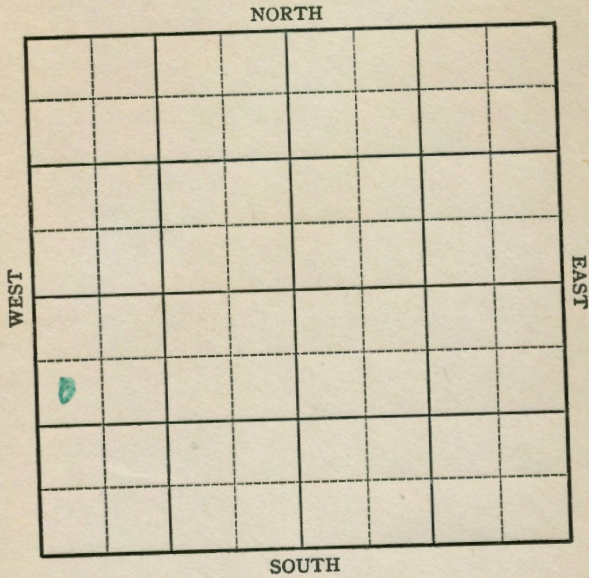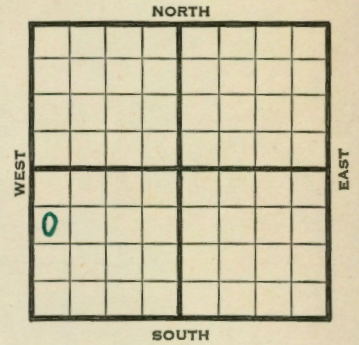

12

1941	REPORT
11/12	Derrick.
11/20	"
11/26	Drlg. 70'
12/4	10" - 167' Drlg. 3303'
12/11	Reagan 3565' 5" - 3566'
	Drlg. 3569' 2000' oil 6-3/4 hours.
12/18	TD 3579
	2500' oil 12 1/2 hrs.
12/23	Reagan 3565'
	5" - 3566'
	T.D. 3581'
	Echometer potential 1834 bbls.
	35. Gravity
	COMPLETED

Map No. 133 Sec. 32 Twp. 5 R. 20W

Well No. 5 Johnson "B"

Cities Service Oil Company

COMPLETED Contractor

SW NW SW

990 Ft. from N. Line

_____ Ft. from S. Line

_____ Ft. from E. Line

330 Ft. from W. Line

SECTION PLAT

RAY POOL

Location _____

Rig up _____

Drilling and Remarks:

*Reason 3565
50 3566.
Ecler P 8/1834*

35-0-93

RECORD

Cased _____ in., _____ ft.

Sand _____

Gas _____

Oil _____

Total Depth 3581

PRODUCTION

1st 24 hrs. Nat. _____

1st 24 hrs. after shot _____

Gas _____ Cu. Ft.

Dry Hole _____

Abandoned _____

Date

DEC 23 1941 19

S. J. LEWIS Scout

Map No. K-133 Sec. 32 Twp. 5 R. 20W

Well No. 5 Johnson "B"

Cities Service Oil Company

FIRST REPORT Contractor

SW NW SW

990 Ft. from N. Line

_____ Ft. from S. Line

_____ Ft. from E. Line

330 Ft. from W. Line

SECTION PLAT

RAY POOL

Location _____

Rig up _____

Drilling and Remarks:

Derrick

RECORD

Cased _____ in., _____ ft.

Sand _____

Gas _____

Oil _____

Total Depth _____

PRODUCTION

1st 24 hrs. Nat. _____

1st 24 hrs. after shot _____

Gas _____ Cu. Ft.

Dry Hole _____

Abandoned _____

Date

NOV 12 1941 19

S. J. LEWIS Scout