


KANSAS

Form 51-5M-7-39-Palace

Phillips

Section 32 Township 5 Range 20-W
 Well No. #1 Ray
 Company Cities Service Oil

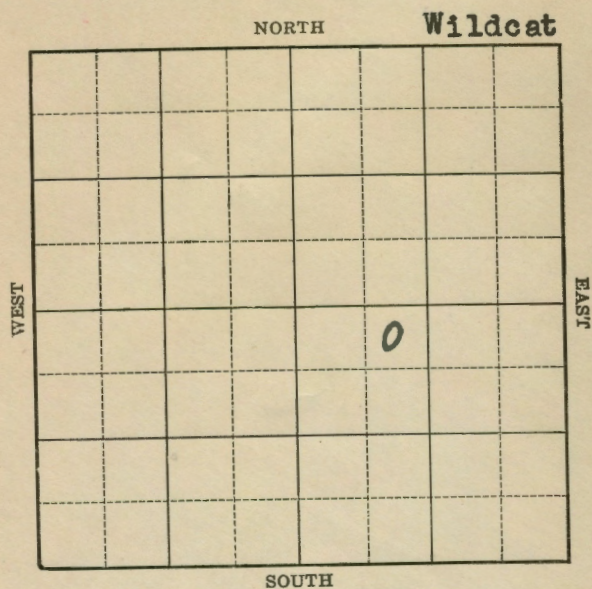


FORM 252-A 5M 4-39

KANSAS

Phillips

Sec. 32 Twp. 5 R. 20-W
 Well No. #1 Ray Farm _____
 Cities Service Oil Company
 (Wildcat)

330 Ft. from N. Line
 _____ Ft. from S. Line
 _____ Ft. from E. Line
990 Ft. from W. Line

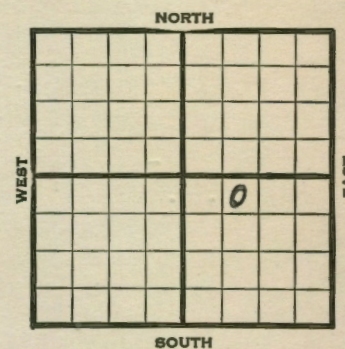

Elev. 2156

1940	REPORT
5/8	Location
5/16	"
5/23	"
5/29	"
6/5	"
6/13	"
6/20	R.U.R.
6/27	12" - 130' Drlg. 2160'
7/3	Drlg. 3005'
7/11	3603' run pipe.
7/18	5" - 3603' SD.
7/25	" "
8/8	" "
8/14	" "
8/20	Lansing 3362-3506 Reagan 3543
	Granite 3585 TD 3603 5" 3603
	Perf. 74 shots 3540-53
	1400' oil 3-3/4 hrs. 1800' oil 5-3/4
	hrs. 2300' OIH 9 hrs. Total fill up
	2900' oil no time given
	32 grav. (Tel)
	OVER

1940

8/28

T.D. 5603'

Potential 858 bbls., pump.

9/4

Reagan 3543'

Granite 3585'

5½" - 3603'

T.D. 3603'

74 shots 3540-53'

48 shots 3553-63'

Echometer potential 2135 bbls.

No water.

COMPLETED

Map No. 133 Sec. 32 Twp. 5 R. 20WWell No. 1 Ray

Cities Service Oil Company

Contractor

COMPLETED

SECTION PLAT

NE NW SE

330 Ft. from N. Line

Ft. from S. Line

Ft. from E. Line

990 Ft. from W. Line

WILDCAT

Location _____

Rig up _____

Drilling and Remarks:

*Reagan 3543**Granite 8578**5 1/2" @ 3603**74 Shot 3540-53**48 " 3553-63**Echo Pt. 2185**No Water*

RECORD

Cased _____ in., _____ ft.

Sand _____

Gas _____

Oil _____

Total Depth 3603

PRODUCTION

1st 24 hrs. Nat. _____

1st 24 hrs. after shot _____

Gas _____ Cu. Ft. _____

Dry Hole _____

Abandoned _____

Date

SEP 4 1940 19

S. J. LEWIS Scout

Map No. 133 Sec. 32 Twp. 5 R. 20WWell No. 1 Ray

Cities Service Oil Company

Contractor

FIRST REPORT

NE NW SE

330 Ft. from N. Line

Ft. from S. Line

Ft. from E. Line

990 Ft. from W. Line

SECTION PLAT

WILDCAT

Location X

Rig up _____

Drilling and Remarks:

RECORD

Cased _____ in., _____ ft.

Sand _____

Gas _____

Oil _____

Total Depth 3603

PRODUCTION

1st 24 hrs. Nat. _____

1st 24 hrs. after shot _____

Gas ✓ Cu. Ft. _____

Dry Hole _____

Abandoned _____

Date

MAY 8 1940 19

S. J. LEWIS Scout