

KANSAS

Form 51-5M-7-40-Palace


Phillips

Section 32 Township 5 Range 20-W

Well No. #2 Ray

Company Cities Service Oil

NORTH Wildcat

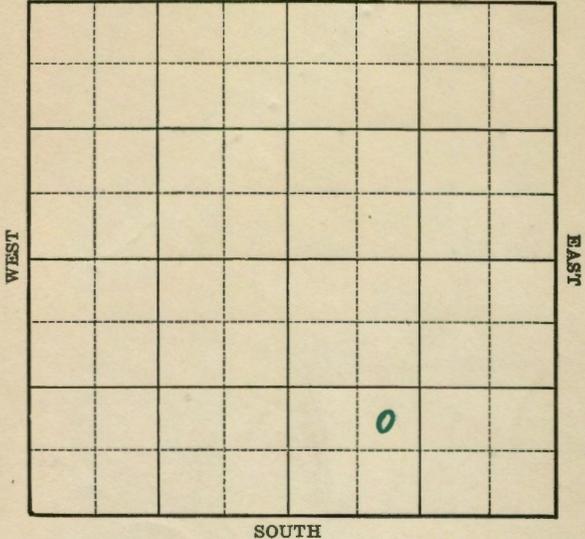

SOUTH

15

Sec. 32 Twp. 5 R. 20-W

Well No. #2 Ray Farm

Cities Service Oil Company


(Wildcat)

Ft. from N. Line

990 Ft. from S. Line

Ft. from E. Line

990 Ft. from W. Line

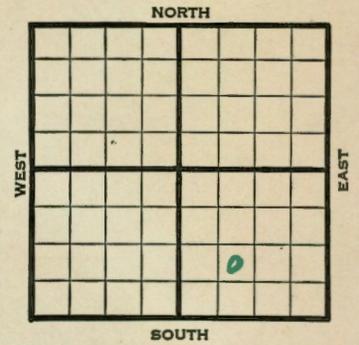

Elev. 2127

1940	REPORT
12/11	Derrick.
12/19	10" - 159' Drlg. 2060'
12/26	Reagan 3522 ³⁵²⁰ Drlg. 3523'
1941	
1/2	Reagan 3520' (Corrected) 5" - 3518' T.D. 3526' 2500' oil in 9½ hours.
1/8	Topeka 3040' Lans. 3349' B.K.C. 3480' Reagan 3520' X 5" - 3518' T.D. 3542' Depthograph potential 2923 bbls. 36.5 Gravity
	COMPLETED

Map No. 133 Sec. 32 Twp. 5 R. 20W

Well No. 2 Ray

Cities Service Oil Company

Contractor

COMPLETED

SECTION PLAT

NE SW SE
Ft. from N. Line
990 Ft. from S. Line
Ft. from E. Line
990 Ft. from W. Line

WILDCAT

Location _____
 Rig up _____
 Drilling and Remarks:
Reagan 8520
5" @ 3515
Dep. H.P. Y2923
36.5 G.U.

RECORD
 Cased _____ in., _____ ft.
 Sand _____
 Gas _____
 Oil _____
 Total Depth 3542

PRODUCTION
 1st 24 hrs. Nat. _____
 1st 24 hrs. after shot _____
 Gas _____ Cu. Ft.
 Dry Hole _____
 Abandoned _____

Date JAN 8 1941 19 S. J. LEWIS Scout

Map No. 123 Sec. 32 Twp. 5 R. 20W

Well No. 2 Ray

Cities Service Oil Company

Contractor

FIRST REPORT

SECTION PLAT

NE SW SE
Ft. from N. Line
990 Ft. from S. Line
Ft. from E. Line
990 Ft. from W. Line

WILDCAT

Location _____
 Rig up _____
 Drilling and Remarks:
 Derrick

RECORD
 Cased _____ in., _____ ft.
 Sand _____
 Gas _____
 Oil _____
 Total Depth _____

PRODUCTION
 1st 24 hrs. Nat. _____
 1st 24 hrs. after shot _____
 Gas _____ Cu. Ft.
 Dry Hole _____
 Abandoned _____

Date DEC 11 1940 19 S. J. LEWIS Scout

Kansas Phillips
 Tract 8040
 Home 3349
 BXC 948
 Well No. 2 Ray
 City Service Oil
 Contractor

568443

SECTION PLAT

COMPLETED
 ME SW SE
 Ft. from N. line
 990 Ft. from E. line
 Ft. from E. line
 990 Ft. from W. line
 WIDCAT

Location
 Risk up
 Drilling and Remarks:

RECD
 Cased
 Sand
 Gas
 Oil

Date
 JAN 2 1924 19

- Misc. Small Maps
- Gards
- Tracing
- France Map
- Scarborough Map
- Moody Map
- Geological Dept.
- Moody Flat Book