

KANSAS


Phillips

Section 32 Township 5 Range 20W

Well No. 4 Ray "A"

Company Barnett Drlg

Phillips
NORTH

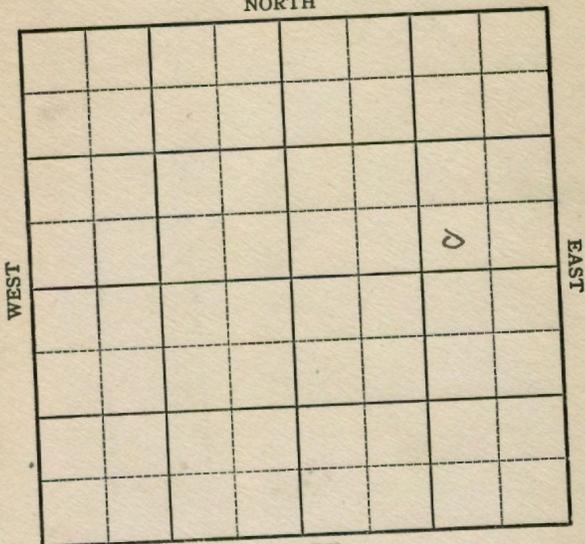

SOUTH

8

KANSAS

Phillips

Sec. 32 Twp. 5 R. 20W ✓

Well No. #4 Ray "A" Farm

Barnett Drlg. Company


Ray Pool

_____ Ft. from N. Line

330' Ft. from S. Line

990' Ft. from E. Line

_____ Ft. from W. Line

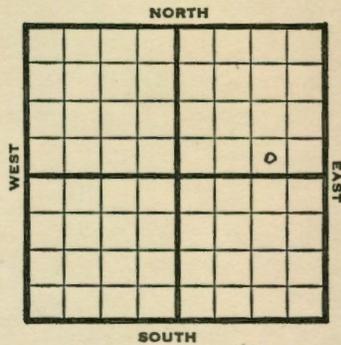

SW SE NE

1949

Elev. 2190' REPORT

3/16

Surface Hole

3/23

8" @ 165'

Drlg. 1770'

3/29

Reagan 3584'

TD 3585

Run 5"

4/6

5" @ 3584½'

TD 3604-2675 Oil

SW 3 hrs.

Pb 3598'

4/12

"

4/20

"

4/27

20 qts 3584-94

HFW Squeeze

5/4

"

5/10

"

5/17

"

5/25

"

6/1

"

6/7

"

6/15

"

6/22

Reagan 3584'

5" @ 3584½'

Pump 150 oil & 2% W Pot.

Gr. 30°

TD 3604'

COMPLETED

Kansas

Map No. W133 Sec. 32 Twp. 5 R. 20W


Well No. 4 Ray "A"

Barnett Drlg. Company

COMPLETE Contractor

SW SE NE

E. 2192
SECTION PLAT

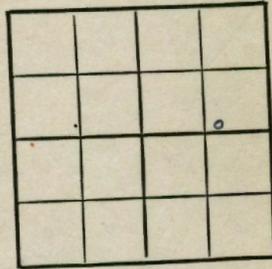

Ft. from N. Line

330 Ft. from S. Line

990 Ft. from E. Line

Ft. from W. Line

Phillips County

Location _____

Rig up _____

Drilling and Remarks:

*Keagan 3574
5" @ 3574 1/2*

*Only soil 12 7/8"
Pet.*

30.00

RECORD

Cased _____ in., _____ ft.

Sand _____

Gas _____

Oil _____

Total Depth 3604

PRODUCTION

1st 24 hrs. Nat. _____

1st 24 hrs. after shot _____

Gas _____ Cu. Ft.

Dry Hole _____

Abandoned _____

Date

JUN 22 1949 19

S. J. LEWIS Scout

Kansas

Map No. _____ Sec. 32 Twp. 5 R. 20W


Well No. 4 Ray "A"

Barnett Drlg. Company

FIRST REPORT Contractor

SW SE NE

SECTION PLAT

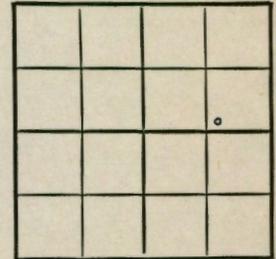

Ft. from N. Line

330 Ft. from S. Line

990 Ft. from E. Line

Ft. from W. Line

Phillips County

Location _____

Rig up _____

Drilling and Remarks:

surface hole

RECORD

Cased _____ in., _____ ft.

Sand _____

Gas _____

Oil _____

Total Depth _____

PRODUCTION

1st 24 hrs. Nat. _____

1st 24 hrs. after shot _____

Gas _____ Cu. Ft.

Dry Hole _____

Abandoned _____

Date

MAR 16 1949 19

S. J. LEWIS Scout