


KANSAS

FORM 51 5M 4-41 PETROL

Phillips

Section 32 Township 5 Range 20-W  
 Well No. 2 Ray "B"  
 Company Cities Service Oil

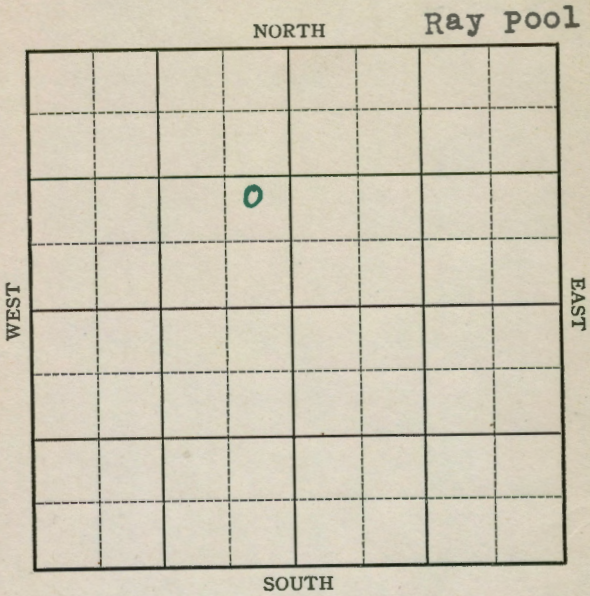


6

FORM 252-A 5M 6-41 PETROL KANSAS Phillips

Sec. 32 Twp. 5 R. 20-W  
 Well No. #2 Ray "B" Farm \_\_\_\_\_  
Cities Service Oil Company \_\_\_\_\_

(Ray)

\_\_\_\_\_ Ft. from N. Line  
1050 Ft. from S. Line  
390 Ft. from E. Line  
 \_\_\_\_\_ Ft. from W. Line

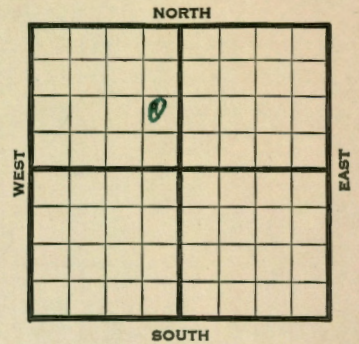

Elev. 2164

| 1941 | REPORT  |
|------|---|
| 8/20 | 8" - 165'<br>Drlg. 2075'  |
| 8/28 | Reagan <del>3563'</del> <sup>3563'</sup> T.D. 52 - 3566'<br>RUST.                                       |
| 9/4  | Reagan <del>3563'</del> <sup>3563'</sup> (Corrected)<br>5" - 3564' T.D. 3585'<br>2675' oil in 11 hours. |
| 9/11 | Pump 495 bbls., potential.<br>1000 acid. Testing.   |
| 9/17 | Reagan 3563'<br>5" - 3564'<br>T.D. 3585'<br>1000 acid.<br>Echometer potential 1661 bbls.<br>34. Gravity |
|      | <b>COMPLETED</b>  |

Map No. 133 Sec. 32 Twp. 5 R. 20W

Well No. 2 Ray "B"

Cities Service Oil Company

COMPLETED Contractor

NE SE NW

SECTION PLAT

\_\_\_\_\_ Ft. from N. Line

1050 Ft. from S. Line

390 Ft. from E. Line

\_\_\_\_\_ Ft. from W. Line

|  |   |  |  |
|--|---|--|--|
|  |   |  |  |
|  | o |  |  |
|  |   |  |  |
|  |   |  |  |

RAY POOL

Location \_\_\_\_\_

Rig up \_\_\_\_\_

Drilling and Remarks:

*Reagan 3563  
51 @ 3564  
1000 acid  
Ech Pt. 1661  
  
340 G*

RECORD

Cased \_\_\_\_\_ in., \_\_\_\_\_ ft.

Sand \_\_\_\_\_

Gas \_\_\_\_\_

Oil \_\_\_\_\_

Total Depth 3585

PRODUCTION

1st 24 hrs. Nat. \_\_\_\_\_

1st 24 hrs. after shot \_\_\_\_\_

Gas \_\_\_\_\_ Cu. Ft.

Dry Hole \_\_\_\_\_

Abandoned \_\_\_\_\_

Date

SEP 17 1941 19

S. J. LEWIS Scout

Map No. 133 Sec. 32 Twp. 5 R. 20W

Well No. 2 Ray "B"

Cities Service Oil Company

FIRST REPORT Contractor

NE SE NW

SECTION PLAT

\_\_\_\_\_ Ft. from N. Line

1050 Ft. from S. Line

390 Ft. from E. Line

\_\_\_\_\_ Ft. from W. Line

|  |   |  |  |
|--|---|--|--|
|  |   |  |  |
|  | o |  |  |
|  |   |  |  |
|  |   |  |  |

RAY POOL

Location \_\_\_\_\_

Rig up \_\_\_\_\_

Drilling and Remarks:

8" - 165  
Drlg. 2075

RECORD

Cased \_\_\_\_\_ in., \_\_\_\_\_ ft.

Sand \_\_\_\_\_

Gas \_\_\_\_\_

Oil \_\_\_\_\_

Total Depth \_\_\_\_\_

PRODUCTION

1st 24 hrs. Nat. \_\_\_\_\_

1st 24 hrs. after shot \_\_\_\_\_

Gas \_\_\_\_\_ Cu. Ft.

Dry Hole \_\_\_\_\_

Abandoned \_\_\_\_\_

Date

AUG 20 1941 19

S. J. LEWIS Scout