

KANSAS

Phillips

Sec. 32 Twp. 5 R. 20-W

Well No. #2 Ray "B" Farm _____

Barnett Drilling et al Company

(Ray)


330 Ft. from N. Line

_____ Ft. from S. Line

_____ Ft. from E. Line

990 Ft. from W. Line

Elv. 2173

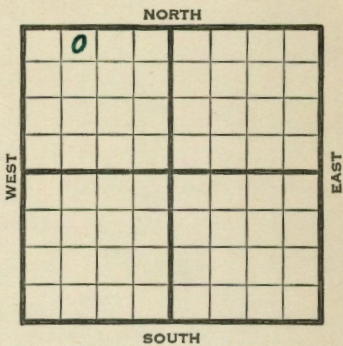

REPORT

1942	
2/4	10" - 125' Drlg. 150'
2/12	Anhy. 1665' Arb. 3568-72' T.D. 7" - 3571' RUST.
2/18	Arb. 3568' Reagan 3571' 7" - 3571' T.D. 3576' Echometer potential 4267 bbls. Maximum 3000 bbls. 35. Gravity
	COMPLETED


KANSAS

Phillips

Section 32 Township 5 Range 20-W

Well No. #2 Ray "B"

Company Barnett Drilling et al

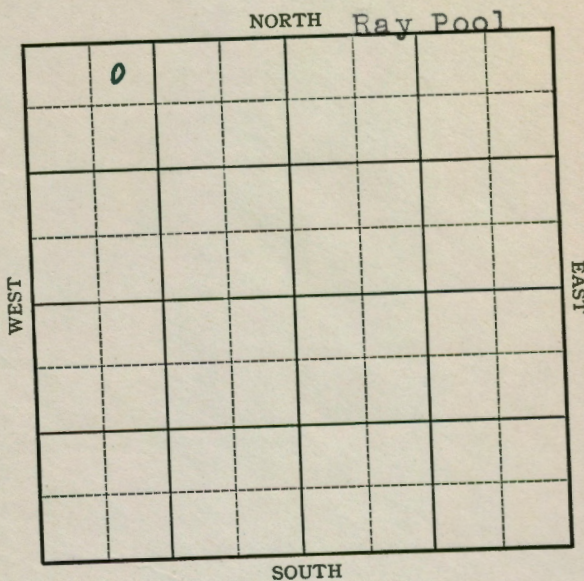

4

Map No. 133 Sec. 32 Twp. 5 R. 20W

Well No. 2 Ray "B"

Barnett Drilling etal. Company

COMPLETED Contractor

NE NW NW

330 Ft. from N. Line

_____ Ft. from S. Line

_____ Ft. from E. Line

990 Ft. from W. Line

SECTION PLAT

0			

RAY POOL

Location _____

Rig up _____

Drilling and Remarks:

Qu 83568
Reagan 3571
7003571
Echo Pad 4267
Map 3000

3529W

RECORD

Cased _____ in., _____ ft.

Sand _____

Gas _____

Oil _____

Total Depth 3526

PRODUCTION

1st 24 hrs. Nat. _____

1st 24 hrs. after shot _____

Gas _____ Cu. Ft.

Dry Hole _____

Abandoned _____

Date

FEB 18 1942 19

S. J. LEWIS Scout

Map No. 133 Sec. 32 Twp. 5 R. 20W

Well No. 2 Ray "B"

Barnett Drilling etal. Company

FIRST REPORT Contractor

NE NW NW

330 Ft. from N. Line

_____ Ft. from S. Line

_____ Ft. from E. Line

990 Ft. from W. Line

SECTION PLAT

0			

RAY POOL

Location _____

Rig up _____

Drilling and Remarks:

10" - 125'
150' Drlg.

RECORD

Cased _____ in., _____ ft.

Sand _____

Gas _____

Oil _____

Total Depth _____

PRODUCTION

1st 24 hrs. Nat. _____

1st 24 hrs. after shot _____

Gas _____ Cu. Ft.

Dry Hole _____

Abandoned _____

Date

FEB 4 1942 19

S. J. LEWIS Scout