


KANSAS

Section 32 Township 5 Range 20W


Well No. 3 Ray "B"

Company Barnett Oil

Barry Pool
NORTH

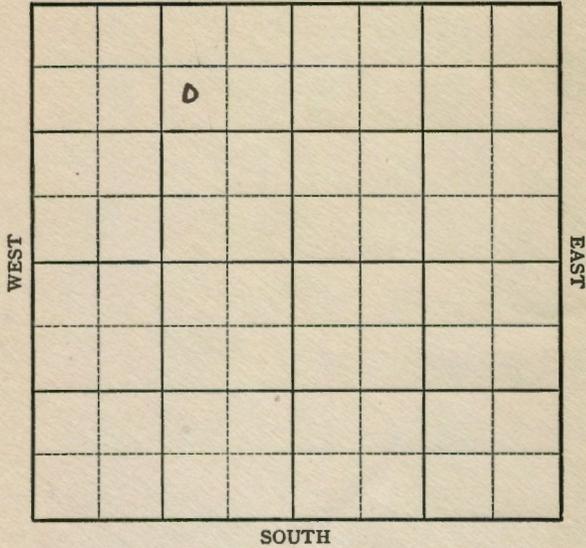

3

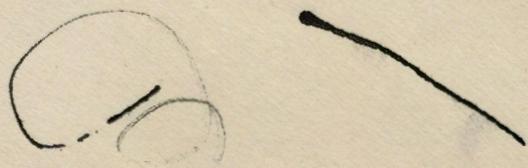

Sec. 32 Twp. 5 R. 20

Well No. #3 Ray "B" Farm

Barnett Oil

Barry Pool


990' Ft. from N. Line

_____ Ft. from S. Line

990' Ft. from E. Line

_____ Ft. from W. Line

SW NE NW

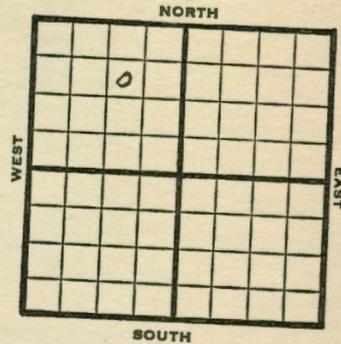

1949 **Elev 2198'** REPORT

3/30 Surface Hole
4/6 8" @ 147'

Arb. 3569'
Reagan 3570-73'
TD 3573'
5" @ 3572'

4/12 "
4/20 TD 3575
2800' oil 2 hrs.
4/20 TD 3575'

Arb. 3569'
Reagan 3570'
5" @ 3572'
Echo Pot 2902' oil
30° Gr.
Comp

COMPLETED

Map No. R133 Sec. 32 Twp. 5 R. 20W

Well No. 3 Ray "B"

Barnett Oil Company

COMPLETE Contractor

SW NE NW

SECTION PLAT

990 Ft. from N. Line

_____ Ft. from S. Line

990 Ft. from E. Line

_____ Ft. from W. Line

Phillips County

Location _____

Rig up _____

Drilling and Remarks:

CR 9569
Diagn 8570
SC 3572
Ec ho Pt 2902 oil
30 2/4

RECORD

Cased _____ in., _____ ft.

Sand _____

Gas _____

Oil _____

Total Depth 35'25"

PRODUCTION

1st 24 hrs. Nat. _____

1st 24 hrs. after shot _____

Gas _____ Cu. Ft.

Dry Hole _____

Abandoned _____

Date

APR 20 1949 19 S. J. LEWIS Scout

Map No. _____ Sec. 32 Twp. 5 R. 20W

Well No. 3 Ray "B"

Barnett Oil Company

FIRST REPORT Contractor

SW NE NW

SECTION PLAT

990 Ft. from N. Line

_____ Ft. from S. Line

990 Ft. from E. Line

_____ Ft. from W. Line

Phillips County

Location _____

Rig up _____

Drilling and Remarks:

surface hole

RECORD

Cased _____ in., _____ ft.

Sand _____

Gas _____

Oil _____

Total Depth _____

PRODUCTION

1st 24 hrs. Nat. _____

1st 24 hrs. after shot _____

Gas _____ Cu. Ft.

Dry Hole _____

Abandoned _____

Date

MAR 30 1949 19 S. J. LEWIS Scout