

KANSAS

FORM 51 5M 4-41 PETROL


Phillips

Section 32 Township 5 Range 20-W

Well No. 3 Ray "B"

Company Cities Service Oil

Ray pool

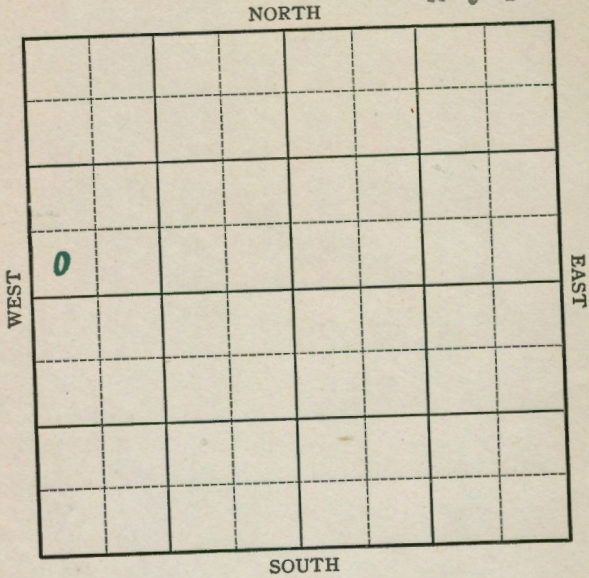

5

FORM 252-A 5M 6-41 PETROL

KANSAS

Phillips

Sec. 32 Twp. 5 R. 20-W

Well No. #3 Ray "B" Farm \_\_\_\_\_

Cities Service Oil Company \_\_\_\_\_

(Ray)


\_\_\_\_\_ Ft. from N. Line

330 Ft. from S. Line

\_\_\_\_\_ Ft. from E. Line

330 Ft. from W. Line

Elev. 2204

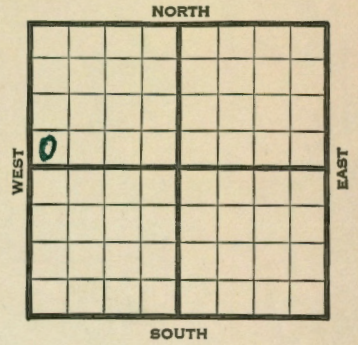

1941	REPORT
8/27	Location
9/4	10" - 160' Drlg. 600'
9/11	Reagan <del>3606</del> <sup>3608</sup> ' T.D. 3608' Run 7".
9/18	Reagan 3608' (Corrected) 7" - 3609' T.D. 3626' 2900' oil 15½ hours.
9/25	Shut down.
9/24	Reagan 3606' 7" - 3609' T.D. 3626' Echometer potential 1649 bbls. 34.3 Gravity
	<b>COMPLETED</b>

Map No. K-133 Sec. 32 Twp. 5 R. 20W

Well No. 3 Ray "B"

Cities Service Oil Company

**COMPLETED** Contractor

SW NW

SECTION PLAT

\_\_\_\_\_ Ft. from N. Line

330 Ft. from S. Line

\_\_\_\_\_ Ft. from E. Line

330 Ft. from W. Line

RAY POOL


Location \_\_\_\_\_

RECORD

Cased \_\_\_\_\_ in., \_\_\_\_\_ ft.

Rig up \_\_\_\_\_

Sand \_\_\_\_\_

Drilling and Remarks:

Gas \_\_\_\_\_

*Reagan 8606*

Oil \_\_\_\_\_

*7" @ 3609*

Total Depth 3626

*Echo 84 1649*

PRODUCTION

1st 24 hrs. Nat. \_\_\_\_\_

1st 24 hrs. after shot \_\_\_\_\_

Gas \_\_\_\_\_ Cu. Ft.

Dry Hole \_\_\_\_\_

Abandoned \_\_\_\_\_

Date

SEP 24 1941 19

S. J. LEWIS Scout

Map No. 133 Sec. 32 Twp. 5 R. 20W

Well No. 3 Ray "B"

Cities Service Oil Company

**FIRST REPORT** Contractor

SECTION PLAT

SW NW

\_\_\_\_\_ Ft. from N. Line

330 Ft. from S. Line

\_\_\_\_\_ Ft. from E. Line

330 Ft. from W. Line

RAY POOL


Location X

RECORD

Cased \_\_\_\_\_ in., \_\_\_\_\_ ft.

Rig up \_\_\_\_\_

Sand \_\_\_\_\_

Drilling and Remarks:

Gas \_\_\_\_\_

Oil \_\_\_\_\_

Total Depth \_\_\_\_\_

PRODUCTION

1st 24 hrs. Nat. \_\_\_\_\_

1st 24 hrs. after shot \_\_\_\_\_

Gas \_\_\_\_\_ Cu. Ft.

Dry Hole \_\_\_\_\_

Abandoned \_\_\_\_\_

Date

AUG 27 1941 19

S. J. LEWIS Scout