

**KANSAS**

Phillips


Section 32 Township 5 Range 20W

Well No. 4 Ray "B"

Company Cities Service

Ray

NORTH

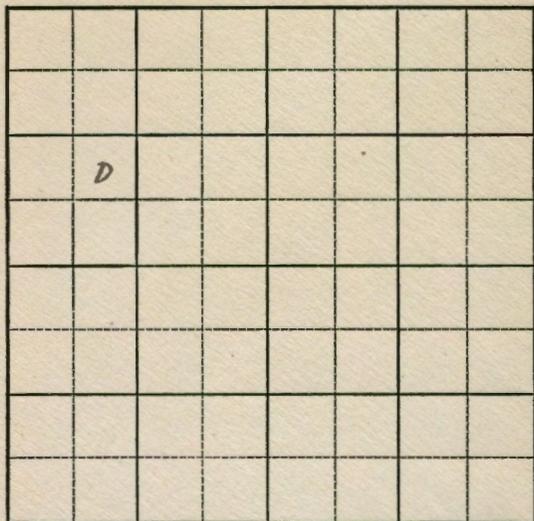

SOUTH

5

**KANSAS**

Phillips

Sec. 32 Twp. 5 R. 20W

Well No. #4 Ray "B" Farm

Cities Service Company


Ray Pool

990' Ft. from N. Line

\_\_\_\_\_ Ft. from S. Line

\_\_\_\_\_ Ft. from E. Line

990' Ft. from W. Line

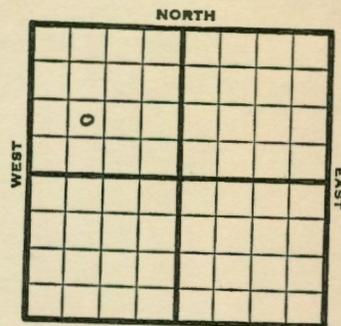

NE SW NW

1949 **Elev 2209'** REPORT

- 4/6 Location
- 4/12 8" @ 210'
- Drlg 2147'
- 4/20 **Lansing 3366'**
- BKC 3559'**
- Reagan 3605'**
- TD 3609
- 5" @ 3606'
- 4/27 TD 3621'
- Pump 300 bbls oil 4 hrs.
- 5/4 TD 3621'
- Reagan 3605'**
- 5" @ 3606'
- Depth Pot 996'
- 30° Gr.
- Comp
- COMPLETED**

Map No. K133 Sec. 32 Twp. 5 R. 20W

Well No. 4 Ray "B"

Cities Service Company

**COMPLETE**

Contractor

NE SW NW

*E. 2209*  
SECTION PLAT

990 Ft. from N. Line

\_\_\_\_\_ Ft. from S. Line

\_\_\_\_\_ Ft. from E. Line

990 Ft. from W. Line

o			

Phillips County

Location \_\_\_\_\_

Rig up \_\_\_\_\_

Drilling and Remarks:

*Reagan 3605*

*5" 03616*

*DELTA 996*

*3028*

RECORD

Cased \_\_\_\_\_ in., \_\_\_\_\_ ft.

Sand \_\_\_\_\_

Gas \_\_\_\_\_

Oil \_\_\_\_\_

Total Depth 2624

PRODUCTION

1st 24 hrs. Nat. \_\_\_\_\_

1st 24 hrs. after shot \_\_\_\_\_

Gas \_\_\_\_\_ Cu. Ft.

Dry Hole \_\_\_\_\_

Abandoned \_\_\_\_\_

Date

MAY 4 1949 19

S. J. LEWIS Scout

Map No. \_\_\_\_\_ Sec. 32 Twp. 5 R. 20W

Well No. 4 Ray "B"

Cities Service Company

**FIRST REPORT** Contractor

NE SW NW

SECTION PLAT

990 Ft. from N. Line

\_\_\_\_\_ Ft. from S. Line

\_\_\_\_\_ Ft. from E. Line

990 Ft. from W. Line

o			

Phillips County

Location X

Rig up \_\_\_\_\_

Drilling and Remarks:

RECORD

Cased \_\_\_\_\_ in., \_\_\_\_\_ ft.

Sand \_\_\_\_\_

Gas \_\_\_\_\_

Oil \_\_\_\_\_

Total Depth \_\_\_\_\_

PRODUCTION

1st 24 hrs. Nat. \_\_\_\_\_

1st 24 hrs. after shot \_\_\_\_\_

Gas \_\_\_\_\_ Cu. Ft.

Dry Hole \_\_\_\_\_

Abandoned \_\_\_\_\_

Date

APR 6 1949 19

S. J. LEWIS Scout