

# KANSAS


Phillips

Section 32 Township 5 Range 20W

Well No. 4 Ray "B"

Company Barnett Oil

Ray  
NORTH

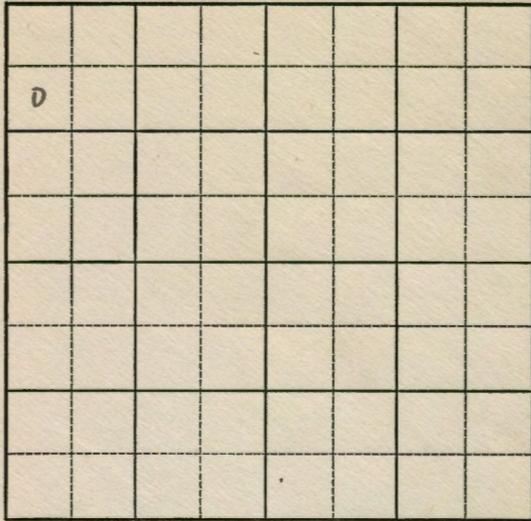

SOUTH

4

# KANSAS

Phillips

Sec. 32 Twp. 5 R. 20W ✓

Well No. #4 Ray "B" Farm

Barnett Oil Company

Ray Pool


990' Ft. from N. Line

\_\_\_\_\_ Ft. from S. Line

\_\_\_\_\_ Ft. from E. Line

330' Ft. from W. Line

SW NW NW

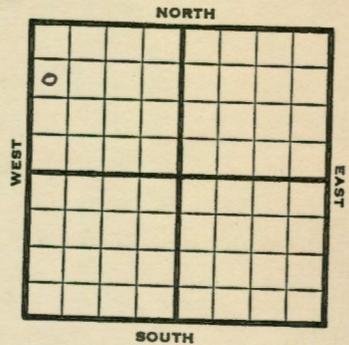

1949 "lev 2217" REPORT

- 4/6 RUR
- 4/12 8" @ 166'
- Drlg 2820'
- 4/20       "
- 4/27 **Lansing 3372'**
- BKC 3569'**
- Reagan 3619-22'**
- TD 3622'
- 5" @ 3620'
- 5/4       TD 3622'
- Reagan 3619'**
- 5" @ 3620'
- Echo Pot
- 3000 Oil
- 30° Gr.
- Comp

**COMPLETED**

Ray Pool

Map No. K 133 Sec. 32 Twp. 5 R. 20W

Well No. 4 Ray "B"

Barnett Oil Company

**COMPLETE** Contractor

SW NW NW

*Fl. 3217*  
SECTION PLAT

990 Ft. from N. Line  
         Ft. from S. Line  
         Ft. from E. Line  
330 Ft. from W. Line

o			

Phillips County

Location \_\_\_\_\_  
Rig up \_\_\_\_\_  
Drilling and Remarks:

*Reagon 3819*  
*5" 60620*  
*Echir P. X*  
*3000 ml*  
*8024*

RECORD

Cased \_\_\_\_\_ in., \_\_\_\_\_ ft.  
Sand \_\_\_\_\_  
Gas \_\_\_\_\_  
Oil \_\_\_\_\_  
Total Depth 3622

PRODUCTION

1st 24 hrs. Nat. \_\_\_\_\_  
1st 24 hrs. after shot \_\_\_\_\_  
Gas \_\_\_\_\_ Cu. Ft.  
Dry Hole \_\_\_\_\_  
Abandoned \_\_\_\_\_

Date

MAY 4 1949 19 S. J. LEWIS Scout

Ray Pool

Map No. \_\_\_\_\_ Sec. 32 Twp. 5 R. 20W

Well No. 4 Ray "B"

Barnett Oil Company

**FIRST REPORT** Contractor

SW NW NW

SECTION PLAT

990 Ft. from N. Line  
         Ft. from S. Line  
         Ft. from E. Line  
330 Ft. from W. Line

o			

Phillips County

Location \_\_\_\_\_  
Rig up \_\_\_\_\_  
Drilling and Remarks:

R U R

RECORD

Cased \_\_\_\_\_ in., \_\_\_\_\_ ft.  
Sand \_\_\_\_\_  
Gas \_\_\_\_\_  
Oil \_\_\_\_\_  
Total Depth \_\_\_\_\_

PRODUCTION

1st 24 hrs. Nat. \_\_\_\_\_  
1st 24 hrs. after shot \_\_\_\_\_  
Gas \_\_\_\_\_ Cu. Ft.  
Dry Hole \_\_\_\_\_  
Abandoned \_\_\_\_\_

Date

APR 6 1949 19 S. J. LEWIS Scout