

KANSAS Phillips


Section 32 Township 5 Range 20W

Well No. 3 Ray "C"

Company Cities Service

Ray Pool

NORTH

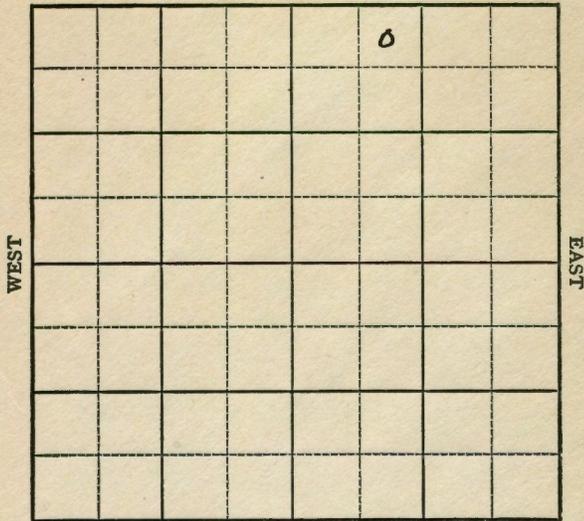

SOUTH

2

KANSAS Phillips

Sec. 32 Twp. 5 R. 20-W

Well No. #3 Ray "C"

Cities Service

Ray Pool


330 Ft. from N. Line

_____ Ft. from S. Line

_____ Ft. from E. Line

990 Ft. from W. Line

N E NW NE

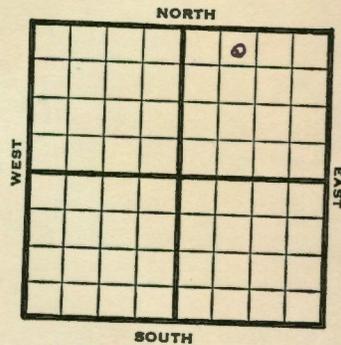

| 1948 | Eli 2206' | REPORT |
|-------|---------------------------|--------|
| 11/3 | RUR | |
| 10/11 | 8" @ 206' | |
| | Lansing 3357' | |
| | Arbuckle 3593' | |
| | Reagan 3596' | |
| | TD 3601' | |
| | 5" @ 3597' | |
| 11/16 | Pump 322 bbls oil 22 hrs. | |
| 11/23 | TD 3601' | |
| | Arb. 3593' | |
| | 5"@ 3597' | |
| | Echo Pot 3000 Oil | |
| | 28° Gr. | |
| | Comp | |
| | COMPLETED | |

Map No. 133 Sec. 32 Twp. 5 R. 20W

Well No. 3 Ray "C"

Cities Service Company

COMPLETE

NE NW NE

Contractor

E. J. 2206

SECTION PLAT

330 Ft. from N. Line

Ft. from S. Line

Ft. from E. Line

990 Ft. from W. Line

| | | | |
|--|--|--|--|
| | | | |
| | | | |
| | | | |
| | | | |

Phillips County

Location _____

Rig up _____

Drilling and Remarks:

Ray 3593
5' 10" 3597
Echo Ray 3008 ml

280 lb

RECORD

Cased _____ in., _____ ft.

Sand _____

Gas _____

Oil

Total Depth 960

PRODUCTION

1st 24 hrs. Nat. _____

1st 24 hrs. after shot _____

Gas _____ Cu. Ft.

Dry Hole _____

Abandoned _____

Date

NOV 23 1948 19

S. J. LEWIS Scout

Map No. _____ Sec. 32 Twp. 5 R. 20W

Well No. 3 Ray "C"

Cities Service Company

FIRST REPORT Contractor

NE NW NE

SECTION PLAT

330 Ft. from N. Line

Ft. from S. Line

Ft. from E. Line

990 Ft. from W. Line

| | | | |
|--|--|--|--|
| | | | |
| | | | |
| | | | |
| | | | |

Phillips County

Location _____

Rig up _____

Drilling and Remarks:

R U R

RECORD

Cased _____ in., _____ ft.

Sand _____

Gas _____

Oil _____

Total Depth _____

PRODUCTION

1st 24 hrs. Nat. _____

1st 24 hrs. after shot _____

Gas _____ Cu. Ft.

Dry Hole _____

Abandoned _____

Date

NOV 3 1948 19

S. J. LEWIS Scout