


KANSAS

Phillips

Section 33 Township 5 Range 20WWell No. 6 Hansen "B"Company Cities Service

Ray Pool

NORTH

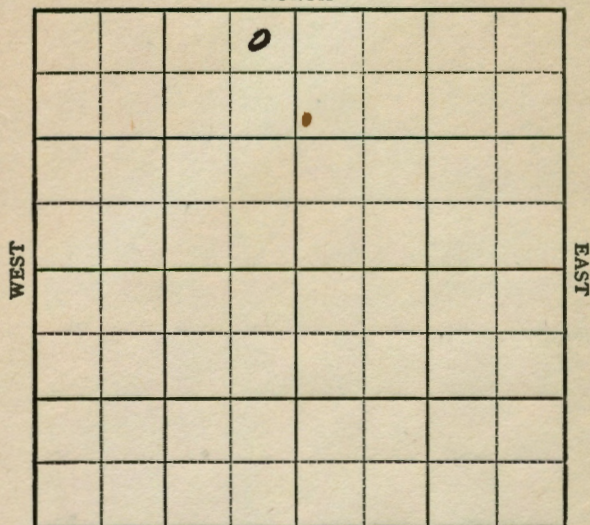

SOUTH

3

Sec. 33 Twp. 5 R. 20-WWell No. #6 Hansen "B" Farm

Cities Service

Company

Ray


330 Ft. from N. Line

Ft. from S. Line

330 Ft. from E. Line

Ft. from W. Line

NE NW

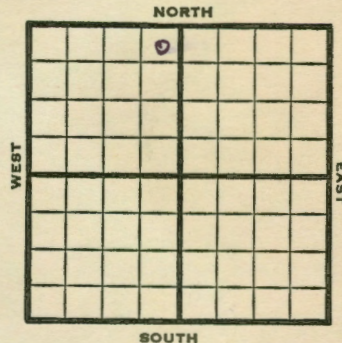

1948

Eli 2180' REPORT

10/6

8"@ 185'

Drlg 2525'

10/13

Lansing 3316'

Arb. 3556'

Reagan 3575'-80'

TD 3580'

5"@ 3575'

10/19

SLM 3580-3575

Lansing 3311

Arb 3551

Reagan 3570'

5"@ 3572'

TD 3580

59 shots 3561-66-1000 acid

Pump 279, bbls oil 13 hrs.

10/27

TD 3580

Arb 3551'

5"@ 3572'

Perf 1000 acid

Depth Pot

2178 Oil

35° Gr.

Comp

COMPLETED

Ray Pool

Map No. 133 Sec. 33 Twp. 5 R. 20WWell No. 6 Hansen "B"

Cities Service Company

COMPLETE

Contractor

NE NW

SECTION PLAT

330 Ft. from N. Line

Ft. from S. Line

330 Ft. from E. Line

Ft. from W. Line

Phillips County

Location

Rig up

Drilling and Remarks:

*cut 3551**5" 08572**Ray**10600 gal**Dep't to Post**2175 oil*

Date

OCT 27 1948

19

S. J. LEWIS

Scout

RECORD

Cased in, ft.

Sand

Gas

Oil

Total Depth *2574*

PRODUCTION

1st 24 hrs. Nat.

1st 24 hrs. after shot

Gas Cu. Ft.

Dry Hole

Abandoned

Ray Pool

Map No. Sec. 33 Twp. 5 R. 20WWell No. 6 Hansen "B"

Cities Service Company

FIRST REPORT Contractor

NE NW

SECTION PLAT

330 Ft. from N. Line

Ft. from S. Line

330 Ft. from E. Line

Ft. from W. Line

Phillips County

Location

Rig up

Drilling and Remarks:

*8" @ 185**drlg. 2525*

Date

OCT 6 1948

19

S. J. LEWIS

Scout

RECORD

Cased in, ft.

Sand

Gas

Oil

Total Depth

PRODUCTION

1st 24 hrs. Nat.

1st 24 hrs. after shot

Gas Cu. Ft.

Dry Hole

Abandoned