


Section 33 Township 5 Range 20WWell No. #3-A Hansen "B"Company Cities Service

NORTH

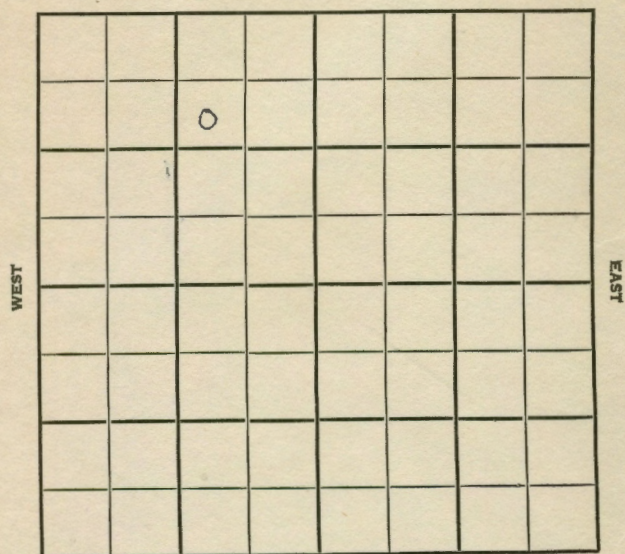

SOUTH

3

SEC. <u>33</u>	TWP. <u>5</u>	R. <u>20W</u>
WELL NO. <u># 3-A Hansen "B"</u>		
COMPANY <u>Cities Service</u>		
CONTRACTOR <u>FARM</u>		

Ft. from N. Line		NORTH	
Ft. from S. Line		0	
1090' Ft. from E. Line		WEST	
Ft. from W. Line		EAST	
SW NE NW (twin well)		SOUTH	

1955	ELEVATION	REPORT
9-14	2137'	LOCATION
10/12	Comm 9-17-55	
	8 5/8" @ 200/230	
	H	3231
	Dodge	3256
	L	3275
	A	3516
	R	3532
	TD	3535
	DST 3312-37 open 1/2 hr Rec 10' mud	
	370/30" DST 3345-70 open 1 hr Rec	
	460' sw 920/30" 5 1/2" @ 3533	
	DD 3538 FU 2549' oil 18 hr	
	Comp 200 BOPD	
	COMPLETED	

County Phillips Elev. 2137
 Sec. 33 Twp. 5 Rge. 20W
 Company Cities Service
 Farm Name Hansen "B" No. 3-A

TOPS	DEPTH	LOG	DATUM	Loc. in Sec.
Anh.				SW NE NW
Tr.				1090' EL
Dg.				(twin well)
Bl.				
L.				
K.C.				
B.K.C.				
Ce.				
C.				
M.				
M.				
K.				
Mz.				
Mo.				
V.				
S.				
S.				
A.				
R.				
Pe.				
G.				
T.D.				

COMPLETED
COMPLETE

Date Comm. 9-17-55 OCT 12 1955
 8 5/8" @ 200/230 DST 3312-37 open 1/2 hr.
 Rec. 10' mud 370/30" DST 3345-70
 open 1 hr., rec. 460' sw 220/30"
 5 1/2" @ 3533 DD 3538 PU 2519 oil
 18 hr. Comp. 200 bopd

County Phillips Elev. 2137
 Sec. 33 Twp. 5 Rge. 20W
 Company Cities Service
 Farm Name Hansen "B" No. 3-A

TOPS	DEPTH	LOG	DATUM	Loc. in Sec.
Anh.				SW NE NW
Tr.				1090' EL
Dg.				(twin well)
Bl.				
L.				
K.C.				
B.K.C.				
Ce.				
C.				
M.				
M.				
K.				
Mz.				
Mo.				
V.				
S.				
S.				
A.				
R.				
Pe.				
G.				
T.D.				

FIRST REPORT
SEP 14 '55

Date Comm.
Location