



FORM 51 25M 3-49 PETROL Phillips **KANSAS**
 Section 33 Township 5 Range 20W
 Well No. #8 Hansen "B"
 Company Cities Service Oil

FORM 252-B
 10M 8-51 TPCO. Phillips **KANSAS** ✓
 Sec. 33 Twp. 5 R. 20 W
 Well No. # 8 Hansen "B" Farm
Cities Service Oil Company
 Contractor

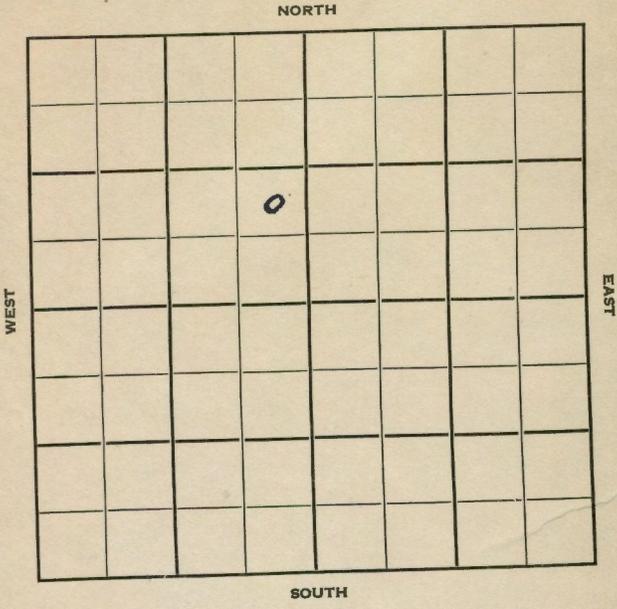

Ray Pool
 Ft. from N. Line
990 Ft. from S. Line
330 Ft. from E. Line
 Ft. from W. Line
 NE SE NW

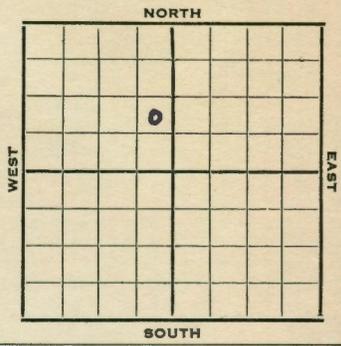

1952	Elev. 2148'	REPORT
10/15		Location
10/22		"
10/29		8" @ 204 Drlg. 2960'
11/5		Heeb. 3255 Dodge 3279 Lans. 3297 B KC 3496 Gorham 3542
		RTD 3545 5" @ 3542
11/12		NR
11/20		CO 3545' P/50 BO 8 hrs.
11/27		NR
12/4		"
12/11		"
12/17		Spud 10-23-52 Oil Well TD 3545 8" @ 204 Heeb 3255, Dodge 3279, Lans 3297, B KC 3496, Gorham 3542, TD 3545 5" @ 3542 CO to 3545 P/50 bo 8 hrs. Comp. 123 bopd

COMPLETED

