KANSAS

FORM 51 5M 10-41 PETROL


Phillips

Section 33 Township 5 Range 20-W

Well No. #1 Kohlman

Company Cities Service Oil

Ray Pool

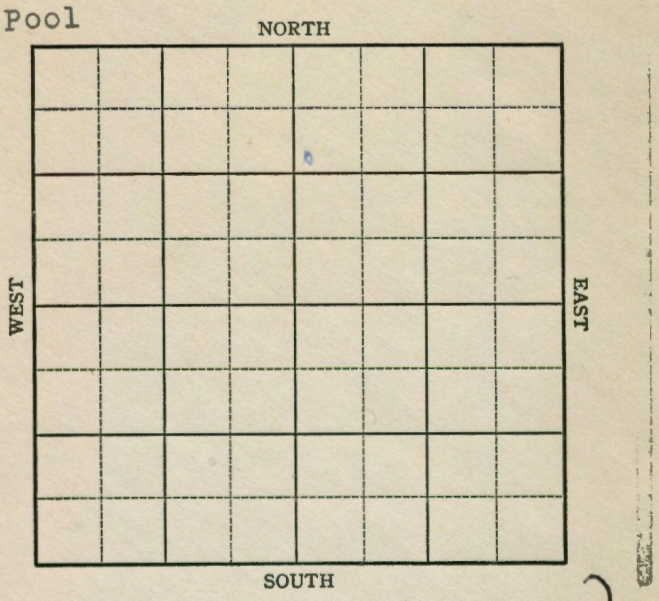

2

Form 252-A
5M 5-42 Petrol

KANSAS Phillips

Sec. 33 Twp. 5 R. 20-W

Well No. #1 Kohlman Farm

Cities Service Oil Company

(Ray Pool)


990 Ft. from N. Line

Ft. from S. Line

Ft. from E. Line

330 Ft. from W. Line

Elev. 2170

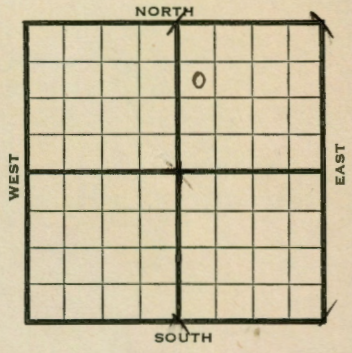

1942	REPORT
9/9	Location
9/16	8" @ 162 WOC
9/23	Drilling 2915'
9/30	TD 3558 Reagan 3550 5" - 3552
10/7	RUST
10/14	TD 3559 2600' oil 17½ hrs.
10/21	TD 3570 Pump 19 oil per hr 5 hrs.
10/28	Reagan 3550' 5" - 3552' T.D. 3570'
1	Pump 400 Pot. Gravity 35.

COMPLETED

Form 26 200 Bks 5-42 Petrol Phillips KANSAS

Map No. 133 Sec. 33 Twp. 5 R. 20W

Well No. 1 Kohlman

Cities Service Oil Company

COMPLETED Contractor

SECTION PLAT

SW NW NE


990 Ft. from N. Line

Ft. from S. Line

Ft. from E. Line

330 Ft. from W. Line

RAY POOL

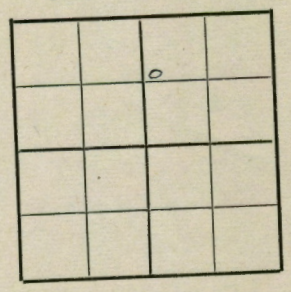

Location

Rig up

Drilling and Remarks:

Reagan 3550
5½ @ 3552
Pump 400 Bbl.

35-0 Gr

RECORD

Cased in., ft.

Sand

Gas

Oil

Total Depth 3590

PRODUCTION

1st 24 hrs. Nat.

1st 24 hrs. after shot

Gas Cu. Ft.

Dry Hole

Abandoned

Date

OCT 2 8 1942 19

S. J. LEWIS Scout

Form 26 200 Bks 5-42 Petrol Phillips KANSAS

Map No. 133 Sec. 33 Twp. 5 R. 20W

Well No. 1 Kohlman

Cities Service Oil Company

FIRST REPORT Contractor

SECTION PLAT

SW NW NE


990 Ft. from N. Line

Ft. from S. Line

Ft. from E. Line

330 Ft. from W. Line

RAY POOL

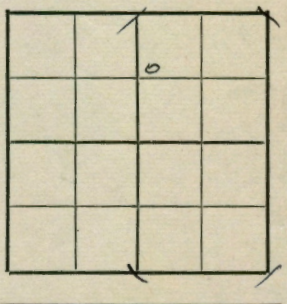

Location XXX

Rig up

Drilling and Remarks:

RECORD

Cased in., ft.

Sand

Gas

Oil

Total Depth

PRODUCTION

1st 24 hrs. Nat.

1st 24 hrs. after shot

Gas Cu. Ft.

Dry Hole

Abandoned

Date

SEP 9 1942 19

S. J. LEWIS Scout