KANSAS

FORM 51 5M 10-41 PETROL

Phillips

Section 33 Township 5 Range 20-W

Well No. #2 Kohlman

Company Cities Service Oil Co.

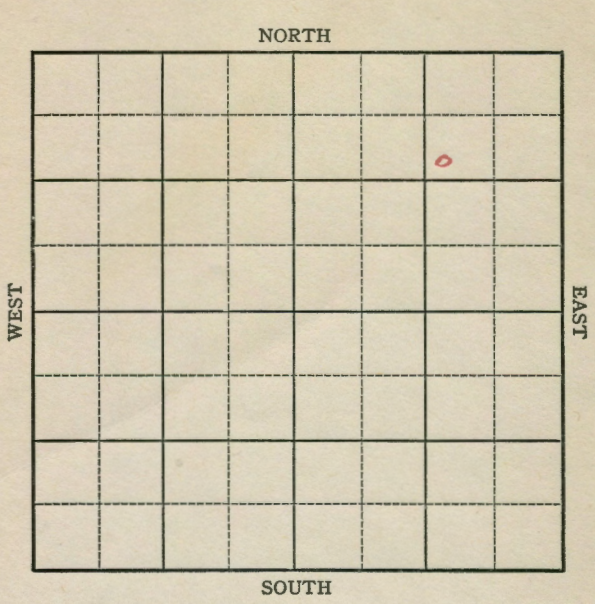

Form 252-A
5M 5-42 Petrol

KANSAS

Phillips

Sec. 33 Twp. 5 R. 20-W

Well No. #2 Kohlman Farm

Cities Service Oil Company

Raypool

990 Ft. from N. Line

Ft. from S. Line

990 Ft. from E. Line

Ft. from W. Line

SW NE NE

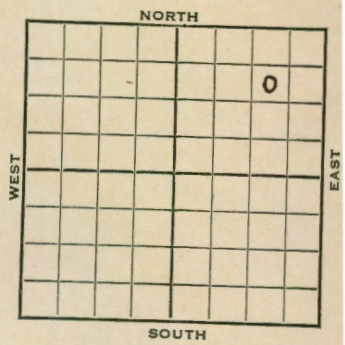

Elev. 2140 DF 2138 Gr.

1942	REPORT
12/16	Rotary
12/22	10" @ 152' Drlg. 3253'
12/29	Drilling 3575'
1943 1/6	Lans. 3267 Reagan 3658 Granite 3754 T.D. 3760 No shows.

ABANDONED

Form 26 200 Bks 5-42 Petrol

KANSAS

Phillips

Map No. 133 Sec. 33 Twp. 5 R. 20W

Well No. 2 Kohlman

Cities Service Oil Company

ABANDONED Contractor

SW NE NE

990 Ft. from N. Line

Ft. from S. Line

990 Ft. from E. Line

Ft. from W. Line

SECTION PLAT

RAY POOL

Location

Rig up

Drilling and Remarks:

Lans 3267
Ragan 3255
Granite 3254
Noskow

RECORD

Cased in., ft.

Sand

Gas

Oil

Total Depth 3760

PRODUCTION

1st 24 hrs. Nat.

1st 24 hrs. after shot

Gas Cu. Ft.

Dry Hole

Abandoned

Date

JAN 6 1943 19 S. J. LEWIS Scout

Form 26 200 Bks 5-42 Petrol

KANSAS

Phillips

Map No. 133 Sec. 33 Twp. 5 R. 20W

Well No. 2 Kohlman

Cities Service Oil Company

FIRST REPORT Contractor

SW NE NE

990 Ft. from N. Line

Ft. from S. Line

990 Ft. from E. Line

Ft. from W. Line

SECTION PLAT

RAYPOOL

Location

Rig up

Drilling and Remarks:

Rotary

RECORD

Cased in., ft.

Sand

Gas

Oil

Total Depth

PRODUCTION

1st 24 hrs. Nat.

1st 24 hrs. after shot

Gas Cu. Ft.

Dry Hole

Abandoned

Date

DEC 16 1942 19 S. J. LEWIS Scout