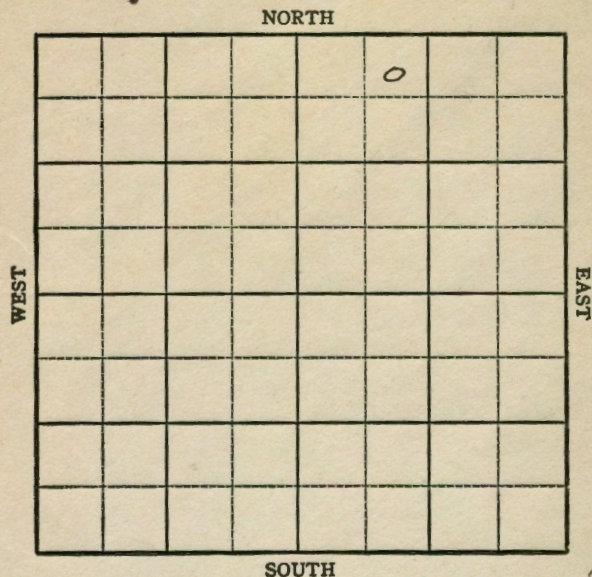


Section 33 Township 5 Range 20-WWell No. #3 KohlmanCompany Cities Service
Ray

2


Sec. 33 Twp. 5 R. 20WWell No. #3 KohlmanCities Service
Ray Pool330' Ft. from N. Line

Ft. from S. Line

Ft. from E. Line

990' Ft. from W. Line

NE NW NE

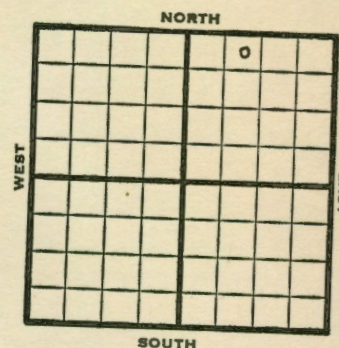

1948 Elev. 2135' REPORT

12/8 Location
12/15 8" @ 196'
Drlg 1425'
12/22 Drlg 3495'
12/29 Lansing 3276'
Gorham 3519(
Arb 3524'
Reagan 3529-31'
TD 3531'
5" @ 3529'

1/5 1000 acid
pump 2½ bbl oil PH for 4 hrs

1/12 TD 3548 Pump 153 & 16 hrs.
1/19 "
1/26 "
2/2 "
2/9 TD 3548'
Pump 123 bbls oil 16 hrs.

2/16 Reagan 3529'
5" @ 3529'
Pump 236 oil Pot.
Gr. 30°
TD 3548'

COMPLETED

Kansas

Map No. K133 Sec. 33 Twp. 5 R. 20WWell No. 3 Kohlman

Cities Service

Company

COMPLETE

Contractor

NE NW NE

SECTION PLAT

330 Ft. from N. Line

Ft. from S. Line

Ft. from E. Line

990 Ft. from W. Line

Phillips County

Location

Rig up

Drilling and Remarks:

*Reagan 286**286 oil*

RECORD

Cased _____ in., _____ ft.

Sand _____

Gas _____

Oil _____

Total Depth 3548

PRODUCTION

1st 24 hrs. Nat. _____

1st 24 hrs. after shot _____

Gas _____ Cu. Ft.

Dry Hole _____

Abandoned _____

Date

FEB 16 1949 19

S. J. LEWIS Scout

Map No. _____ Sec. 33 Twp. 5 R. 20WWell No. 3 Kohlman

Cities Service

Company

FIRST REPORT

Contractor

NE NW NE

SECTION PLAT

330 Ft. from N. Line

Ft. from S. Line

Ft. from E. Line

990 Ft. from W. Line

Phillips County

Location X

Rig up

Drilling and Remarks:

RECORD

Cased _____ in., _____ ft.

Sand _____

Gas _____

Oil _____

Total Depth _____

PRODUCTION

1st 24 hrs. Nat. _____

1st 24 hrs. after shot _____

Gas _____ Cu. Ft.

Dry Hole _____

Abandoned _____

Date

DEC 8 1948 19

S. J. LEWIS Scout