


Section 33 Township 5 Range 20-W

Well No. #1 Nichol

Company Cities Service Oil

Ray Pool

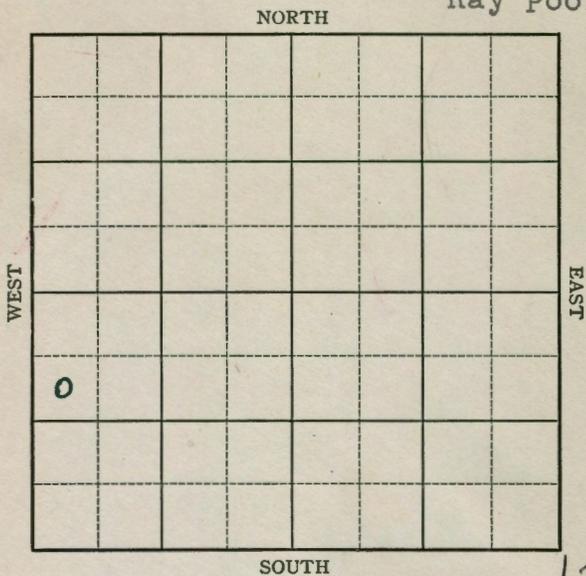

12

Sec. 33 Twp. 5 R. 20-W

Well No. #1 Nichol Farm \_\_\_\_\_

Cities Service Oil Company \_\_\_\_\_


(Ray)

990 Ft. from N. Line

\_\_\_\_\_ Ft. from S. Line

\_\_\_\_\_ Ft. from E. Line

330 Ft. from W. Line

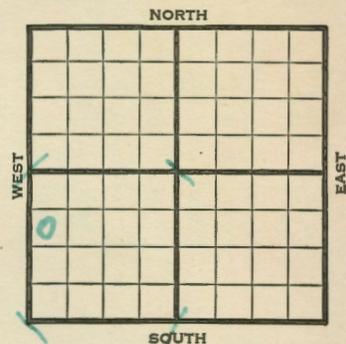

Elev. 2175

1941	REPORT
5/27	10" - 165' WOC.
6/5	Drlg. 3580'
6/12	Reagan 3578' 5" - 3578'
	T.D. 3588' 2500' oil 19½ hours
6/19	T.D. 3601' Echometer test
	1569 bbls. oil - 2000 acid.
	Testing.
6/25	Reagan 3578'
	5" - 3578'
	T.D. 3601'
	2000 acid.
	Echometer potential 2593 bbls.
	33.6 Gravity
	<b>COMPLETED</b>

KANSAS KANSAS


Map No. 133 Sec. 33 Twp. 5 R. 20W

Well No. 1 Nichol  
Cities Service Oil Company  
Contractor

COMPLETED

SECTION PLAT

SW NW SW  
990 Ft. from N. Line  
Ft. from S. Line  
Ft. from E. Line  
330 Ft. from W. Line

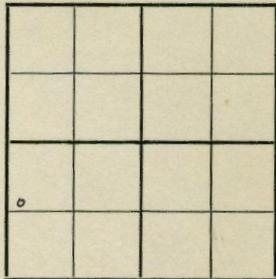

RAY POOL

Location \_\_\_\_\_  
Rig up \_\_\_\_\_  
Drilling and Remarks:  
*Reagan 3578.*  
*5" @ 3578.*  
*2000 quol*  
*Ech 10 2593*  
  
*33 @ 44*

RECORD  
Cased \_\_\_\_\_ in., \_\_\_\_\_ ft.  
Sand \_\_\_\_\_  
Gas \_\_\_\_\_  
Oil \_\_\_\_\_  
Total Depth 3601

PRODUCTION  
1st 24 hrs. Nat. \_\_\_\_\_  
1st 24 hrs. after shot \_\_\_\_\_  
Gas \_\_\_\_\_ Cu. Ft.  
Dry Hole \_\_\_\_\_  
Abandoned \_\_\_\_\_

Date JUN 25 1941 19 S. J. LEWIS Scout


Map No. 133 Sec. 33 Twp. 5 R. 20W

Well No. 1 Nichol  
Cities Service Oil Company  
Contractor

FIRST REPORT

SECTION PLAT

SW NW SW  
990 Ft. from N. Line  
Ft. from S. Line  
Ft. from E. Line  
330 Ft. from W. Line

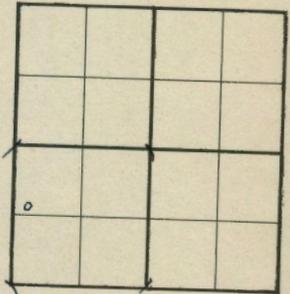

RAY POOL

Location \_\_\_\_\_  
Rig up \_\_\_\_\_  
Drilling and Remarks:  
10" - 165  
WOC

RECORD  
Cased \_\_\_\_\_ in., \_\_\_\_\_ ft.  
Sand \_\_\_\_\_  
Gas \_\_\_\_\_  
Oil \_\_\_\_\_  
Total Depth \_\_\_\_\_

PRODUCTION  
1st 24 hrs. Nat. \_\_\_\_\_  
1st 24 hrs. after shot \_\_\_\_\_  
Gas \_\_\_\_\_ Cu. Ft.  
Dry Hole \_\_\_\_\_  
Abandoned \_\_\_\_\_

Date MAY 27 1941 19 S. J. LEWIS Scout