



Section 26 Township 5 Range 21W
 Well No. #1 Hansen
 Company Helmerick & Payne C S O

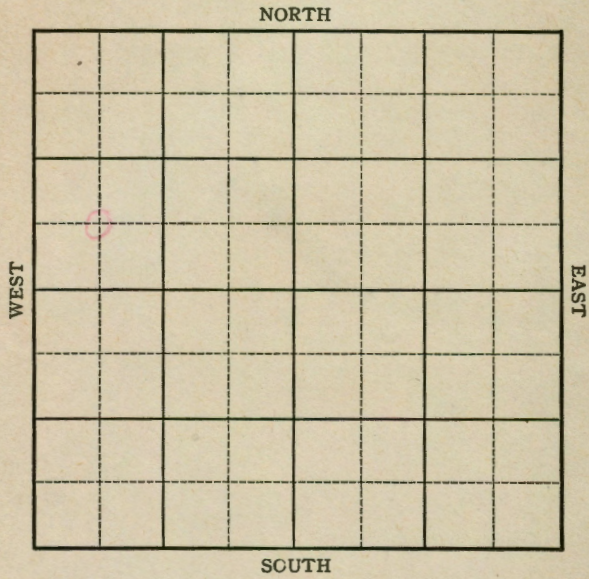

Sec. 26 Twp. 5 R. 21W
 Well No. #1 Hansen Farm
Helmerick & Payne C.S.O. Company

Wildcat

_____ Ft. from N. Line
660 Ft. from S. Line
 _____ Ft. from E. Line
660 Ft. from W. Line
 C SW NW Elev. 2242

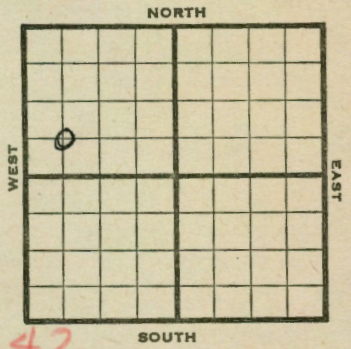

1945

REPORT

3/14 10" @ 148
 Anhy 1810
 Drlg 2660
 3/23 Lans 3338
 BKC 3572
 Gorham 3612
 Arb. 3653
 TD 3720 Run Casing
 3/29 Arb 3650
 TD 3720
 5" @ 3717
 8 shots to 3638-45
 8 shots 3646-3653
 11 shots 3650-3654
 8 shots 3650-3654
 2800' fluid in 6 hrs.
 4/5 " " " " " "
 4/12 PB 3694-24 shots 3650-3654
 12 shots 3654-3656
 Swab 5 oil per hr.
 4/20 " " " " " "
 4/26 " " " " " "
 5/9 Arb 3650
 5" @ 3717
 Perf. Arb.
 TD 3712
 Pump 102 oil plus 5% wtr. Pot.
 Grav. 30.0

COMPLETED

Pool Name Wildcat

Map No. 133 Sec. 26 Twp. 5 R. 21W

Well No. 1 Hansen

Helmerick & Payne C.S.O. Company

FIRST REPORT Contractor

C SW NW

SECTION PLAT

_____ Ft. from N. Line

660 Ft. from S. Line

_____ Ft. from E. Line

660 Ft. from W. Line

Norton

Location _____

Rig up _____

Drilling and Remarks:

10" - 148

Anhy 1810

2660

RECORD

Cased _____ in., _____ ft.

Sand _____

Gas _____

Oil _____

Total Depth _____

PRODUCTION

1st 24 hrs. Nat. _____

1st 24 hrs. after shot _____

Gas _____ Cu. Ft.

Dry Hole _____

Abandoned _____

Date _____

MAR 14 1945 19 _____

S. J. LEWIS Scout

Pool Name Ray West

Map No. 133 Sec. 26 Twp. 5 R. 21W

Well No. 1 Hansen

Helmerick & Payne Company

COMPLETED Contractor

C SW NW

E 12242

SECTION PLAT

_____ Ft. from N. Line

660 Ft. from S. Line

_____ Ft. from E. Line

660 Ft. from W. Line

Norton County

Location _____

Rig up _____

Drilling and Remarks:

Case 3650

5' @ 3212

Perf. @ 2.

Pump 102 w/ 75% water

24.

30° S.

RECORD

Cased _____ in., _____ ft.

Sand _____

Gas _____

Oil _____

Total Depth 3212

PRODUCTION

1st 24 hrs. Nat. _____

1st 24 hrs. after shot _____

Gas _____ Cu. Ft.

Dry Hole _____

Abandoned _____

Date _____

MAY 9 1945 19 _____

S. J. LEWIS Scout