


Section 26 Township 5 Range 21W

Well No. #3 Kemper

Company Phillips Petr.

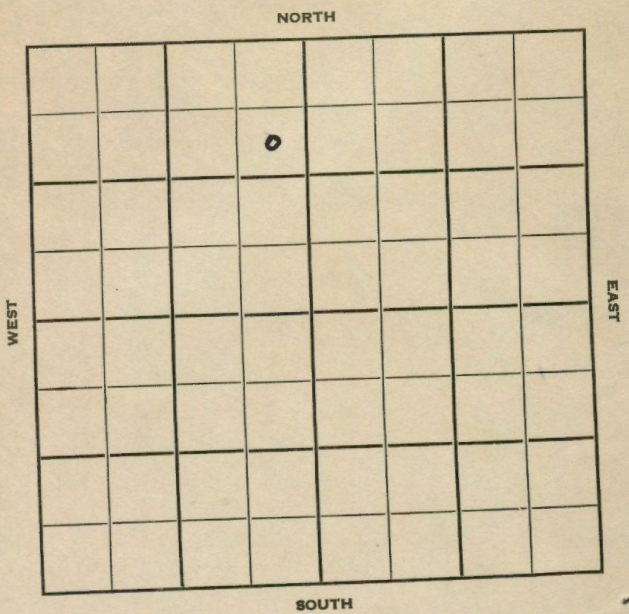

Sec. 26 Twp. 5 R. 21W

Well No. #3 Kemper Farm \_\_\_\_\_

Phillips Pet. Company \_\_\_\_\_

Contractor \_\_\_\_\_


990 Ft. from N. Line

\_\_\_\_\_ Ft. from S. Line

330 Ft. from E. Line

\_\_\_\_\_ Ft. from W. Line

SE NE NW

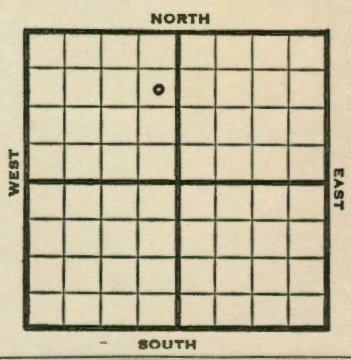

1952	Elev. 2247'	REPORT
10/1		Cellar & Pits
10/8		Spud 10-1-52 8" @ 426 Topeka 3219, Heeb 3389, Toronto 3413, Lans 3434 Drlg. 3554'
10/15		BKC 3620, Arb 3664 RTD 3669 5" @ 3665' CO to 3669, 500A, S/1½ BO & 73 BW 3 hrs., testing
10/22		DD 3671' S/5 BO 7 41 BWPD PB 3663' 6/3661-63 sq off wtr CO 3677 B/2 BO & 2% wtr 1 hr.
10/29		DD 3683' TD S/1½ BO plus 2% wtr 3 hrs. POP
11/5		P/ 54 Bopd & 1% wtr.
11/12		Spud 10-1-52 Oil well TD 3683' 8" @ 426 Top 3219' Heeb 3389', Tor. 3413', Lans. 3434' B KC 3620', Arb. 3664', TD 3669' 5" @ 3665' CO to 3669' B/37 GO 5 hr. 40 gal A 10 GPH 500 A S/1½ BO 73 BW 3-3/4 hrs. DD 3671 S/5 BO 41 BWPD PB 3663'

OVER

1952

11/12

(Information continued)

6/3661-63 CO to 3677' B/2 BO 2% wtr

DD 3683' S/1½ BO 2% wtr. 3 hr.

P/54 BOPD 1% wtr.

Comp. 32 BOPD 1½ BW

**COMPLETED**

