

Section 26 Township 5 Range 21W

Well No. #4 Kemper

Company Phillips Pet.

Sec. 26 Twp. 5 R. 21W

Well No. #4 Kemper Farm

Phillips Pet. Company

Phillips Contractor

W. Ray Pool



Ft. from N. Line

330 Ft. from S. Line

330 Ft. from E. Line

Ft. from W. Line

SE SE NW

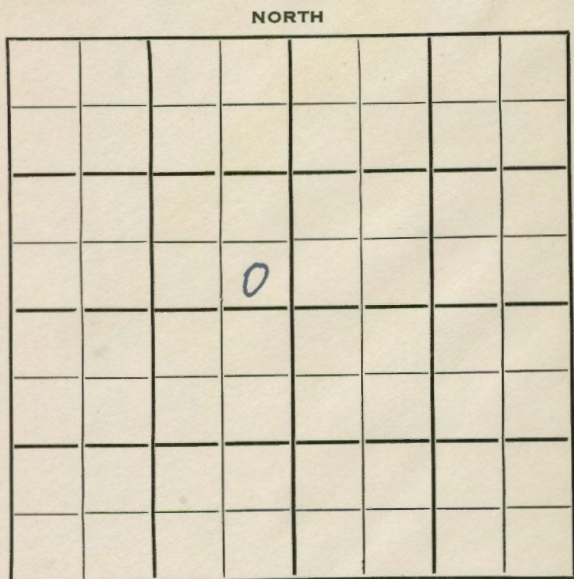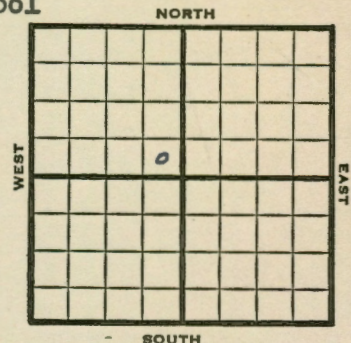

SOUTH

1953 **Elev. 2235'** REPORT

4/29 Location  
 5/7 "  
 5/22 8" @ 475 Anhy 1830' Top 3204  
 Heeb 3377 Tor 3402 Lans 3419  
 B KC 3609 Gorham 3641-46 Arb 3651  
 TD 3655 5" @ 3650

5/28 CO 3655 B/ 37 goph 2 hrs. DD 3668  
 TD  
 S/ 13½ BO 9 Hrs. POP.

6/3 P/32 bopd

6/10 Spud 5-10-53  
 Oil Well  
 TD 3668'  
 8" @ 475'  
 Anhy 1830, Top 3204, Heeb 3377, Tor  
 3402, Lans 3419, B KC 3609, Gorham  
 3641, Arb 3651,  
 TD 3655'  
 5" @ 3650'  
 CO to 3655  
 B/ 37 goph 2 hr. DD 3668 S/ 13½ bo  
 9 hr. P/ 32 bopd  
 Comp. 32 bopd 2½ bw.

COMPLETED

