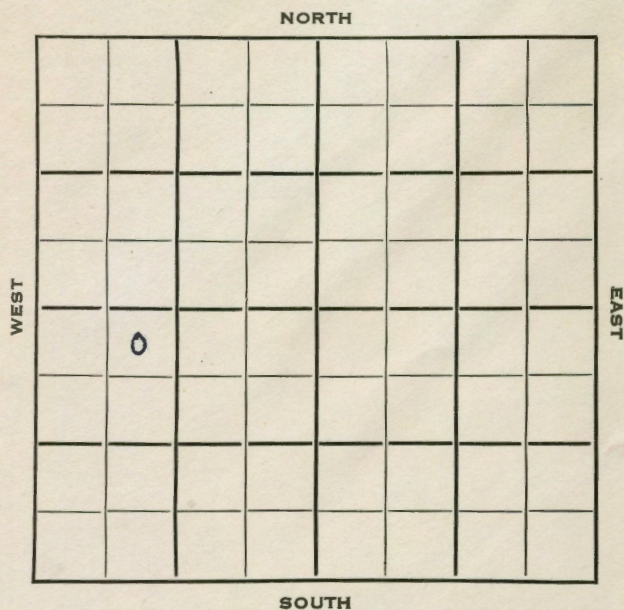


Section 13 Township 5 Range 21WWell No. #1 BairdCompany Berry & Fick

12

SEC. 13 TWP. 5 R. 21 W ✓

WELL NO.

1 Baird

COMPANY

FARM

Berry & Fick

CONTRACTOR

Murfin Drlg.

Wildcat

330


Ft. from N. Line

Ft. from S. Line

Ft. from E. Line

990

Ft. from W. Line

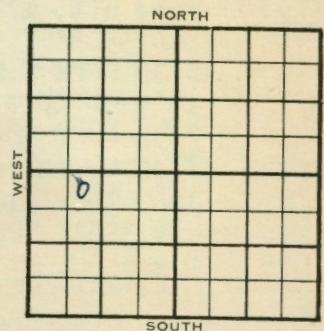NE NW SW
Phillips & Texas - DHM

ELEVATION	REPORT
1954 2104'	

1/27

Spud 1-24-54
8" @ 188 WOC

2/3

Top 3097' Anhy 1700' Heeb 3260'
Tor 3288' Lans 3301'
DST 3343-64'

2/10

DST 3343-64', 1 hr., 50' m, 240' sw,
1210#
B KC 3494', Arb. 3544'
DST 3490-3553' RTD, 2 hrs., 20' free
oil, 178' hly ocm, 610# Schl
5" @ 3546'

2/17

WOCT

3/3

DD 3554' TD S/30 GPH 3 hrs.
500 A S/5 BOPH 1½ hrs.
FU 770' oil. 13 hrs.

3/10

NR

3/31

P/32 BOPD


OVER

1954
5/19

Spud 1-24-54 D & A TD 3568
8" @ 188 Anhy 1700 Top 3097
Heeb 3260 Tor. 3288 Lams 3301
DST 3343-64 open 1 hr rec 50' mud
240' SW 1210# B KC 3494
Arb. 3544
DST 3490-3553 open 2 hr rec 20'
free oil, 178' HOCM 610#
TD 3553' 5" @ 3546 DD 3554
S/30 GOPH 5 hr. 400 A S/5 BOPH
1½ hr. FU 770' oil 13 hr.
P/32 BOPD 1000 A S/22 BO 10% wtr.
P/22 BO 10% wtr. Dec. to 10 BOPD
10% wtr. 1000 A P/4 BO 10% wtr.
DD 3567 DD 3568 HFW
D & A

ABANDONED

County Norton State Kansas
 Sec. 13 (Blk. 5 (Sur. 21W Map No.
 Operator Berry & Fick
 Well No. 1 Farm Baird
 Elev. 2104 Location NE NW SW

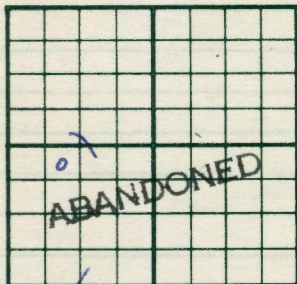

330 Ft. From N Line SW
 990 Ft. From W Line Quarter
 1st. Report
 Completion MAY 19 1954
 Remarks Wildcat
Murfin Drlg. - Contr.
 Spudding Date 1-24-54

Drlg. Data D & A TD 3568

8" @ 188 Anhy 1700 Top. 3097

Heeb. 3260 Tor. 3288 Lans. 3301

DST 3343-64 open 1 hr. Rec. 50' mud

240' sw 1210# B KC 3494 Arb. 3544

DST 3490-3553 open 2 hr. Rec. 20' free

oil 178' hoem 610# TD 3553 5" @ 3546

DD 3554 S/ 30 goph 5 hr. 400 A

S/ 5 boph 1 1/2 hr. FU 770' oil 13 hr.

P/ 32 bopd 1000 A S/ 22 bo 10% wtr.

P/ 22 bo 10% wtr. dec. to 10 bopd


10% wtr. 1000 A P/ 4 bo 10% wtr.

DD 3567 DD 3568 HFW

D & A

J. G. McGEHEE

County Norton State Kansas
 Sec. 13 (Blk. 5 (Sur. 21W Map No.
 Operator Berry & Fick
 Well No. 1 Farm Baird
 Elev. 2104 Location NE NW SW

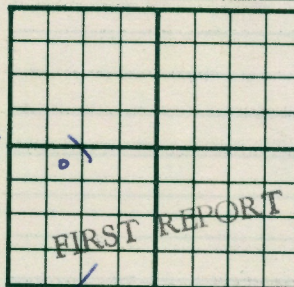

330 Ft. From N Line SW
 990 Ft. From W Line Quarter
 1st. Report JAN 27 1954
 Completion
 Remarks Phillips & Texas DHH
Murfin Drlg. - Contr.
 Spudding Date 1-24-54

Drlg. Data

8" @ 188 WOC

Wildcat

J. G. McGEHEE