KANSAS Norton


FORM 51 25M 3-49 PETROL

Section 25 Township 5 Range 21W

Well No. #2 Finnigan

Company Cities Service

Ray Pool

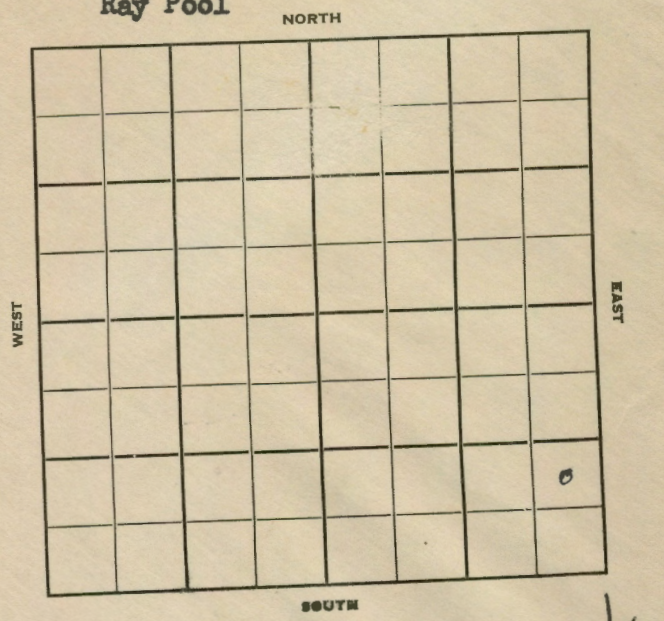

16

FORM 252-B
10M 9-49 PETROL

Norton KANSAS

Sec. 25 Twp. 5 R. 21W

Well No. #2 Finnigan Farm

Cities Service Company

Rine Drlg. Contractor

Ray Pool


_____ Ft. from N. Line

990' Ft. from S. Line

330' Ft. from E. Line

_____ Ft. from W. Line

NE SE SE

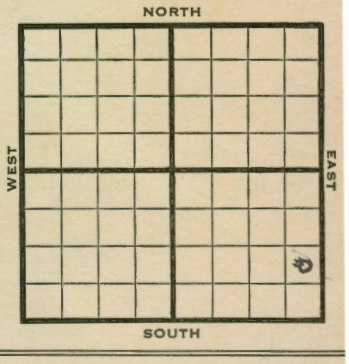

1949	Elev 2244' REPORT
10/26	8" @ 206'
11/1	Drlg. 3640'
11/9	Lansing 3434' BKC 3626' Reagan 3672' TD 3674' 5" @ 3673'
11/16	TD 3675' Reagan 3672' 5"@ 3673' Echo Pot 1090' Oil 30° Gr. Comp

COMPLETED

Form 26 200 Bks. 6-49 Petrol

Kansas

Ray Pool

Map No. ____ Sec. 25 Twp. 5 R. 21W

Well No. 2 Finnigan


Cities Service Company

Rine Drlg. Contractor

NE SE SE

FIRST REPORT

SECTION PLAT

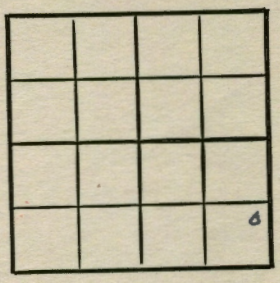

____ Ft. from N. Line

990 Ft. from S. Line

330 Ft. from E. Line

____ Ft. from W. Line

Norton County

Location ____

Rig up ____

Drilling and Remarks:

8" @ 206

RECORD

Cased ____ in., ____ ft.

Sand ____

Gas ____

Oil ____

Total Depth ____

PRODUCTION

1st 24 hrs. Nat. ____

1st 24 hrs. after shot ____

Gas ____ Cu. Ft.

Dry Hole ____

Abandoned ____

Date

OCT 26 1949 19

S. J. LEWIS Scout

Form 26 200 Bks. 6-49 Petrol

Kansas

Ray Pool

Map No. ____ Sec. 25 Twp. 5 R. 21W

Well No. 2 Finnigan


C S O Company

COMPLETE Contractor

NE SE SE

El. 2244

SECTION PLAT

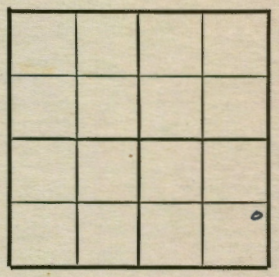

____ Ft. from N. Line

990 Ft. from S. Line

330 Ft. from E. Line

____ Ft. from W. Line

Norton County

Location ____

Rig up ____

Drilling and Remarks:

Reagan 3672.

5" @ 3673

Ec hr RT 1090

n l

80 2 4

RECORD

Cased ____ in., ____ ft.

Sand ____

Gas ____

Oil ____

Total Depth 3675'

PRODUCTION

1st 24 hrs. Nat. ____

1st 24 hrs. after shot ____

Gas ____ Cu. Ft.

Dry Hole ____

Abandoned ____

Date

NOV 16 1949 19

S. J. LEWIS Scout