


Norton

SECTION 25 TOWNSHIP 5S RANGE 21W

WELL NO. #3 Finnegan

COMPANY Cities Service

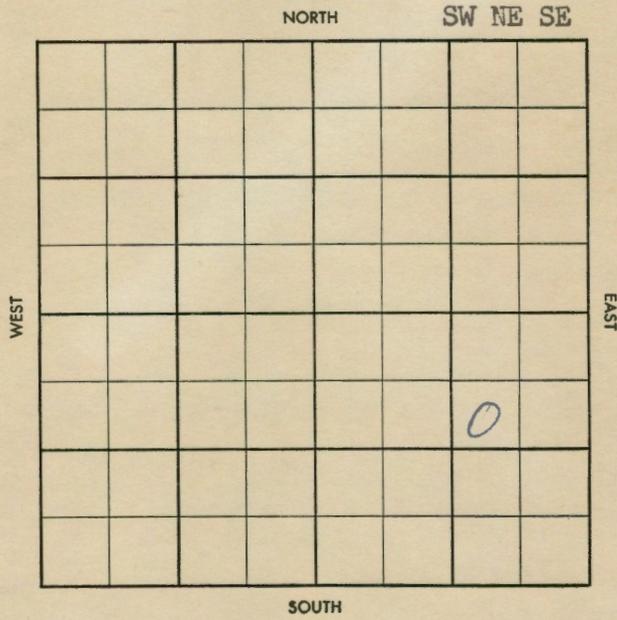

9

