


Norton

KANSAS

SECTION 27 TOWNSHIP 5S RANGE 21W

WELL NO. #1 Kendrick

COMPANY Jocelyn-Varn

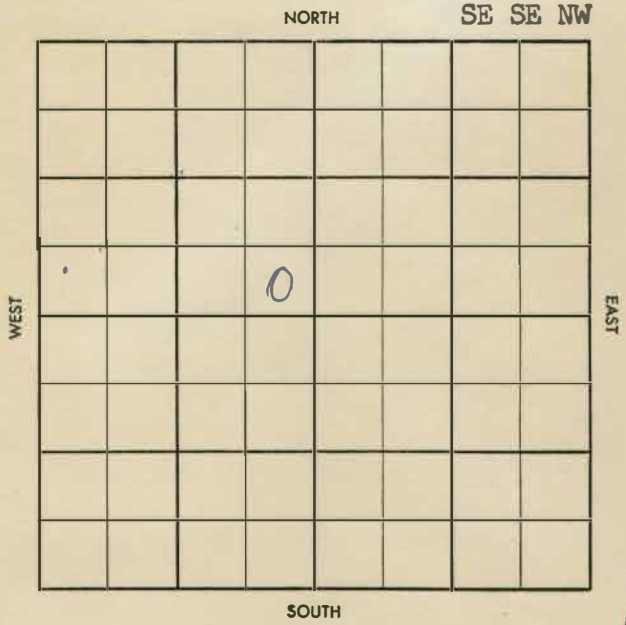

S 513-A

S-513.A

CO. ~~Norton~~ ELEV. 2177
 SEC. 27 TWP. 5 RGE. 21W
 COMPANY Jocelyn-Varn NO. 1

SEP 25 '57

FIRST REPORT

FARM Kendrick
 LOC. SESE NW

Heeb.	3323
Tor.	3348
Lans.	3368
Reagan	3599
TD	3603

GEOL.
 CONTR. Trusco
 POOL W. Ray
 SPUD 9-18-57
8" @ 222 5" @ 3600
DST 3594-3603
open 1 hr. rec.
2050' oil 990/20"

NO. SEC. TWP. RGE.

CO. ~~Norton~~ ELEV. 2177
 SEC. 27 TWP. 5 RGE. 21W
 COMPANY Jocelyn-Varn NO. 1

COMPLETE
 DEC 18 '57

FARM Kendrick
 LOC. SESE NW

Heeb.	3323
Tor.	3348
Lans.	3368
Reagan	3599
TD	3603

GEOL.
 CONTR. Trusco
 POOL W. Ray
 SPUD 9-18-57
8" @ 222 5" @ 3600
DST 3594-3603
open 1 hr. rec.
2050' oil 990/20"
CO 3603
Fu 1100' oil NW

NO. SEC. TWP. RGE.

1 in B12BOPH 3 1/2 hrs 2300
of BOT 7 OR
POP POP

25BOPH NW

Reagan 3600-037D