


Norton

KANSAS

SECTION 27 TOWNSHIP 5S RANGE 21W

WELL NO. #2 Kendrick

COMPANY Jocelyn & Varn

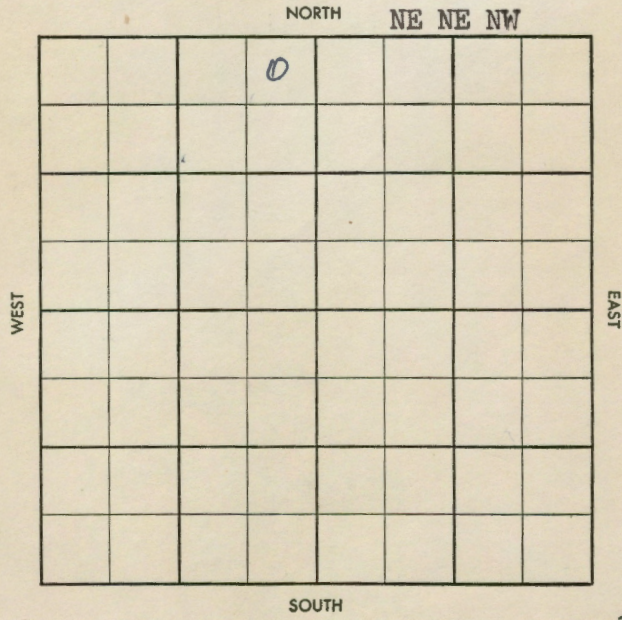

3

Top X Pool X  
 Co. X Foot X

S-513-B

County Norton Elev. 2208  
 Sec. 27 Twp. 5 Rge. 21W  
 Company Jocelyn & Varn  
 Farm Name Kendrick No. 2

TOPS	DEPTH	LOG	DATUM	Loc. in Sec.
Anh.				<u>NE NE NW</u>
Tr.	<u>3353</u>			
H.	<u>3380</u>			
Dg.				
B.L.				
L.	<u>3399</u>			Geol.
K.C.				Contr.
B.K.C.				<u>Trusco</u>
Ce. <u>Gorham sd</u>	<u>3632</u>			Pool
C.				
M.				
K.				
Mz.				
Mq.				
V.				
S.				
S.				
A.	<u>3636</u>			<b>FIRST REPORT</b>
R.				
Pf.				
G.				
T.D.	<u>3639</u>			<u>JUL 30 '58</u>

Date Comm. 7-9-58  
8 5/8" @ 214/160 DST 3629-34  
open 1 hr., rec. 4' oil 10' ocm  
360/20" 5 1/2" @ 3637

Top X Pool X  
 Co. X Foot X

S-513-B

County Norton Elev. 2208  
 Sec. 27 Twp. 5 Rge. 21W 2211RB  
 Company Jocelyn & Varn  
 Farm Name Kendrick No. 2

TOPS	DEPTH	LOG	DATUM	Loc. in Sec.
Anh.				<u>NE NE NW</u>
Tr.	<u>3353</u>			
H.	<u>3380</u>			
Dg.				
B.L.				
L.	<u>3399</u>			Geol.
K.C.				Contr.
B.K.C.				<u>Trusco</u>
Ce. <u>Gorham sd</u>	<u>3632</u>			Pool <u>Raynes</u>
C.				
M.				
K.				
Mz.				
Mq.				
V.				
S.				
S.				
A.	<u>3636</u>			<b>COMPLETE</b>
R.				
Pf.				
G.				
T.D.	<u>3639</u>			<u>AUG 27 '58</u>

Date Comm. 7-9-58  
8 5/8" @ 214/160 DST 3629-34  
open 1 hr., rec. 4' oil 10' ocm  
360/20" 5 1/2" @ 3637 AUG 6 '58 Co 3639  
\$ 4.67 BO NW 2 hrs 200' OB  
FU 700' oil 6 hrs \$ 2.44  
Boph NW 6 hrs T&R AUG 13 '58  
AUG 20 '58 AUG 27 '58 P4 Boph NW 12 hrs  
P25 Boph NW