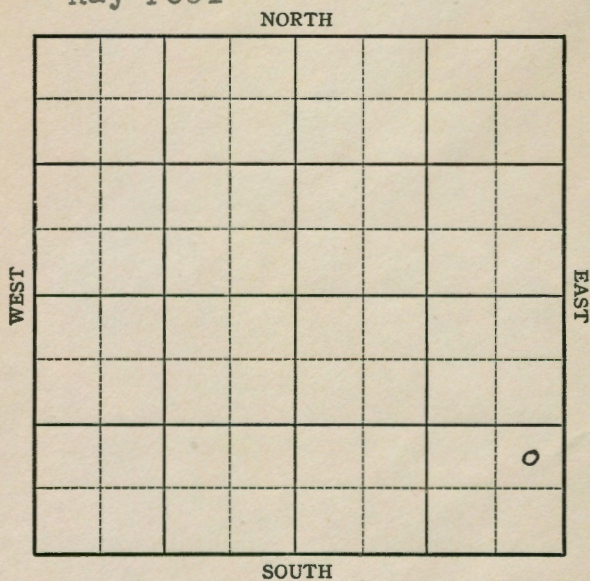


KANSAS

FORM 51 5M 10-41 PETROL

Norton

Section 36 Township 5 Range 21-WWell No. #2 KitzkeCompany Cities Service Oil
Ray Pool

16

Form 252-A
5M 5-42 Petrol


KANSAS

Sec. 36 Twp. 5 R. 21-WWell No. #2 Kitzke FarmCities Service Oil Company

(Ray Pool)

 Ft. from N. Line990 Ft. from S. Line330 Ft. from E. Line Ft. from W. Line

Elev. 2188

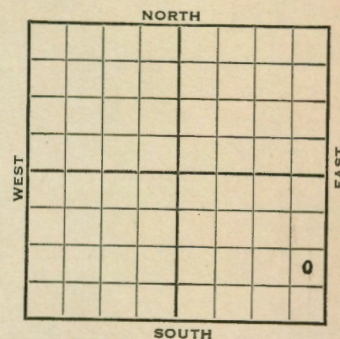

1942

REPORT

7/29

Derrick

8/5

10" - 156

Drlg. 2970'

8/12

Reagan

Granite 3604'

T.D. 3611

ABANDONED

Map No. 133 Sec. 36 Twp. 5 R. 21WWell No. 2 Kitzke

Cities Service Oil Company

FIRST REPORT

Contractor

NE SE SE

SECTION PLAT

Ft. from N. Line

990 Ft. from S. Line330 Ft. from E. Line

Ft. from W. Line

RAY POOL

Location

Rig up

Drilling and Remarks:

Derrick

RECORD

Cased in, ft.

Sand

Gas

Oil

Total Depth

PRODUCTION

1st 24 hrs. Nat.

1st 24 hrs. after shot

Gas Cu. Ft.

Dry Hole

Abandoned

Date

JUL 29 1942 19

S. J. LEWIS Scout

Map No. 133 Sec. 36 Twp. 5 R. 21WWell No. 2 Kitzke

Cities Service Oil Company

ABANDONED

Contractor

NE SE SE

SECTION PLAT

Ft. from N. Line

990 Ft. from S. Line330 Ft. from E. Line

Ft. from W. Line

RAY POOL

Location

Rig up

Drilling and Remarks:

Reagan
Granite 3604

RECORD

Cased in, ft.

Sand

Gas

Oil

Total Depth 9611

PRODUCTION

1st 24 hrs. Nat.

1st 24 hrs. after shot

Gas Cu. Ft.

Dry Hole

Abandoned

Date

AUG 12 1942 19

S. J. LEWIS Scout