


Norton

KANSAS

SECTION 27 TOWNSHIP 5S RANGE 21W

WELL NO. #1 Wiltrot

COMPANY Phillips Petr.

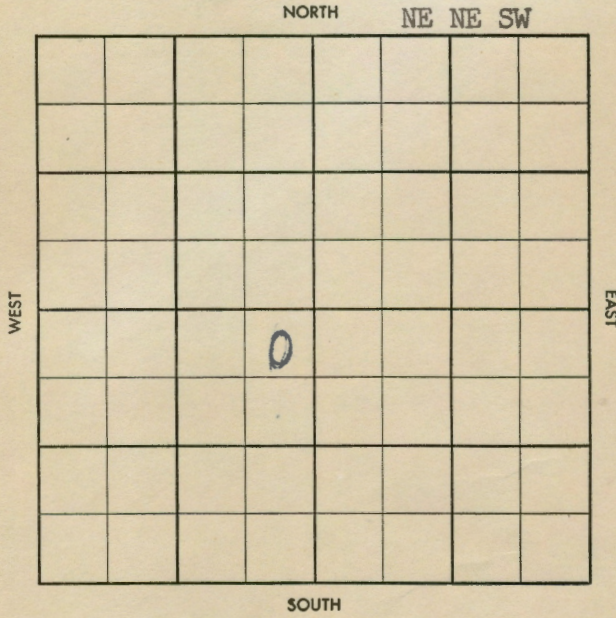

||

