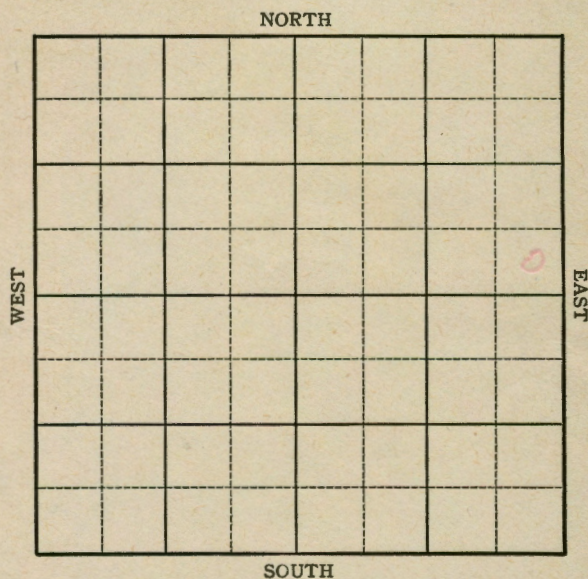


Norton County

Section 27 Township 5S Range 21WWell No. #1 WiltroupCompany Cities Service Oil

KANSAS

Norton

Sec. 27 Twp. 5 R. 21WWell No. #1 Wiltroup FarmCities Service Oil Company


Wildcat

Ft. from N. Line

330 Ft. from S. Line330 Ft. from E. Line

Ft. from W. Line

SE NE

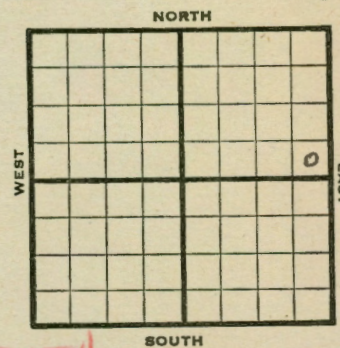Edw. 2254

1945

REPORT

3/21 Location
3/29 8" @ 188'
Drlg. 2420'

4/5 **Lans** 3357-3553 SO
4/12 **Gorham** 3633-50
Arb 3671-75 TD
Sat. 5" @ 3672 RUST

4/20 **SLM** 3675-3671
Arb 3667
5" @ 3668
TD 3678
120' oil 1½ hrs.

4/26 500 acid. HFW PB
5/3 PB 3670
5/16 **Arb** 3667
5" @ 3668
TD 3675

ABANDONED

Kansas Pool Name WildcatMap No. 133 Sec. 27 Twp. 5 R. 21WWell No. 1 WiltroupCities Service Oil Company

ABANDONED

Contractor

SE NE

E12254

SECTION PLAT

Ft. from N. Line

330 Ft. from S. Line330 Ft. from E. Line

Ft. from W. Line

Norton County

Location

Rig up

Drilling and Remarks:

Cr 83667
5 "e3668"

RECORD

Cased in. ft.

Sand

Gas

Oil

Total Depth 3625

PRODUCTION

1st 24 hrs. Nat.

1st 24 hrs. after shot

Gas Cu. Ft.

Dry Hole

Abandoned

Date

MAY 16 1945S. J. LEWIS ScoutPool Name WildcatMap No. 133 Sec. 27 Twp. 5 R. 21WWell No. 1 WiltroupCities Service Oil Company

FIRST REPORT

Contractor

SE NE

SECTION PLAT

Ft. from N. Line

330 Ft. from S. Line330 Ft. from E. Line

Ft. from W. Line

Norton

Location X

Rig up

Drilling and Remarks:

RECORD

Cased in. ft.

Sand

Gas

Oil

Total Depth

PRODUCTION

1st 24 hrs. Nat.

1st 24 hrs. after shot

Gas Cu. Ft.

Dry Hole

Abandoned

Date

MAR 21 1945S. J. LEWIS Scout