

DX 78-1


Norton

KANSAS

Section 27 Township 5 Range 21W

Well No. #2 Wilttrout

Company Jocelyn-Varn Oil Co.

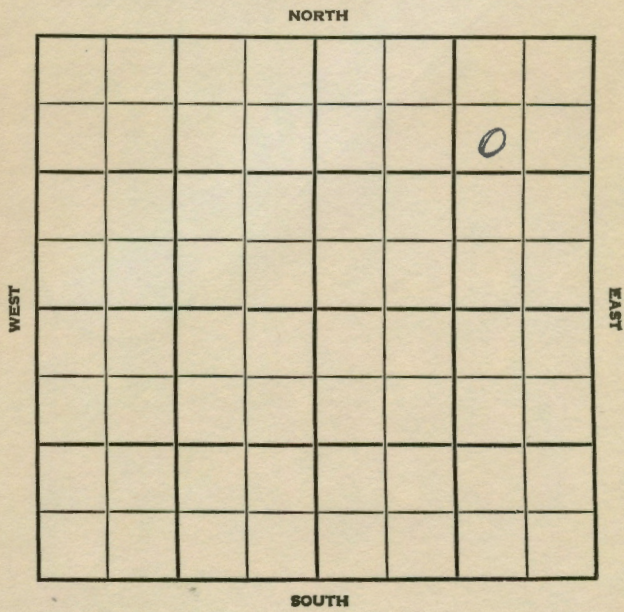

|

County Norton Elev. _____
 Sec. 27 Twp. 5 Rge. 21W
 Company Jocelyn-Varn Oil Co.
 Farm Name Wiltrout No. 2

TOPS	DEPTH	LOG	DATUM	Loc. in Sec.
Anh.				SW NE NE
Tr.				
H.				
Tr.				
Dg.				
Bl.				
L.				Geol.
K.C.				Contr.
B.K.C.				Brack Tools
Ce.				Pool
C.				Ray NW
M.				
M.				
K.				
Mz.				
Me.				
V.				
S.				
S.				
A.				
R.				
Pe.				
G.				
T.D.				

Date Comm. 12-3-56
8" @ 248 w/175, WOC

Co.

Loc.

NO

Sec.

T.

R.

County Norton Elev. 2197
 Sec. 27 Twp. 5 Rge. 21W
 Company Jocelyn-Varn Oil Co.
 Farm Name Wiltrout No. 2

TOPS	DEPTH	LOG	DATUM	Loc. in Sec.
Anh.				SW NE NE
Tr.				
H.		3347		
Tr.		3377		
Dg.				
Bl.				
L.		3391		Geol.
K.C.				Contr.
B.K.C.		5584		Brack Tools
Ce.				Pool
C.				Ray NW
M.				
M.				
K.				
Mz.				
Me.				
V.				
S.				
S.				
A.		3620	3623	
R.				
Pe.				
G.				
T.D.		3624		

Date Comm. 12-3-56
8" @ 248 w/175, WOC DEC 12 '56 ID 3441
DEC 13 '56 5/2 3622/75 MICT DEC 25 '56
JAN 2 '57 DD 3642 @ 19 60ph
no/w PB 3626 1/2" channelled
59d co 3626 @ 19 60ph +
2 6-wph 1/2" @ 20 BFPH 80%
oil pop #110 57 EST P.
30 Bopd + 50 Bw in 24 hrs
JAN 25 '57 JAN 30 '57 P. 25 Bopd + Tr. wtr

JAN 30 '57
 COMPLETE