


Norton

KANSAS

SECTION 27 TOWNSHIP 5 RANGE 21W

WELL NO. ~~##~~ #3 Wiltrot

COMPANY Jocelyn & Varn Oil Co.

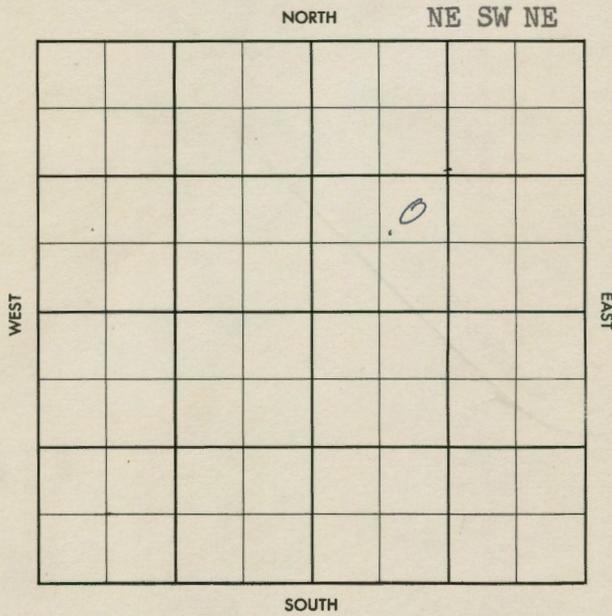

7

County Norton Elev. 2207
 Sec. 27 Twp. 5 Rge. 21W
 Company Jocelyn & Varn Oil Co.
 Farm Name Wiltrout No. 3

TOPS	DEPTH	LOG	DATUM	Loc. in Sec.
				NE SW NE
Anh.				
TP.	3351			
H.	3380			
Tr.				
Dg.				
BL.	3397			Geol. Ray Goodin
L.				Contr. Trusco Drilg.
K.C.				Pool Ray W.
B.K.C.				
Ce.				
C.				
M.				
K.				
Mz.				
Me.				
V.				
S.				
S.				
A- <u>Reag</u>	3629			
R.				
PE.				
G.				
TD.	3631			

AUG 14 '57
 COMPLETE

Date Comm. 6-4-57
 Spudding JUN 12 '57 8 5/8 230/150
Ø 3420 JUN 19 '57 5 1/2 3630/100
JUN 20 '57 CO 3631 Ø 3 1/2 BOP 1hr.
no/w FU ~~290~~ 290' oil 2 hrs
no/w \$ 3130 no/w 10 hrs
 Pop JUL 3 '57 JUL 10 '57 JUL 17 '57 JUL 24 '57 JUL 31 '57
 AUG 8 '57 AUG 14 '57 P. 40 BOPd 3% wt
 comp 25 BOPd 3% wt.

County Norton Elev. _____
 Sec. 27 Twp. 5 Rge. 21W
 Company Jocelyn & Varn Oil Co.
 Farm Name Wiltrout No. 3

TOPS	DEPTH	LOG	DATUM	Loc. in Sec.
Anh.				NE SW NE
TP.				
H.				
Tr.				
Dg.				
BL.				
L.				Geol. Ray Goodin
K.C.				Contr. Trusco Drilg.
B.K.C.				Pool Ray W.
Ce.				
C.				
M.				
M.				
K.				
Mz.				
Me.				
V.				
S.				
S.				
A				
R.				
PE.				
G.				
TD.				

FIRST REPORT
 JUN 5 '57

Date Comm. 6-4-57

Spudding

~~5~~