

Norton


KANSAS

SECTION 27 TOWNSHIP 5 RANGE 21W

WELL NO. #1 Wiltrot "C"

COMPANY Jocelyn & Varn Oil

NORTH NW NW SE

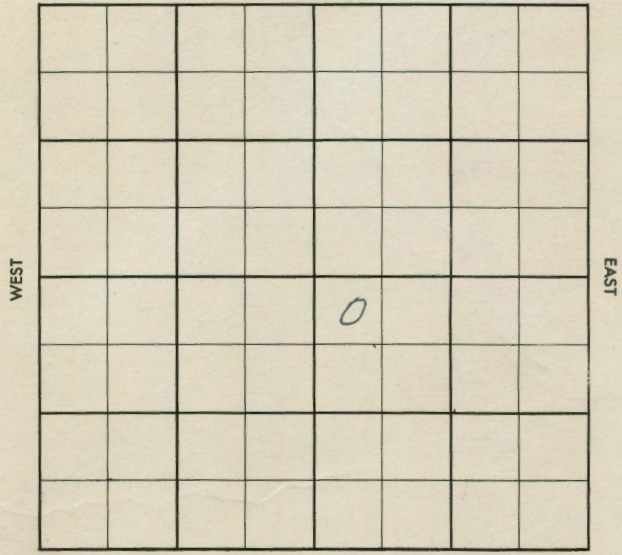

SOUTH

10

