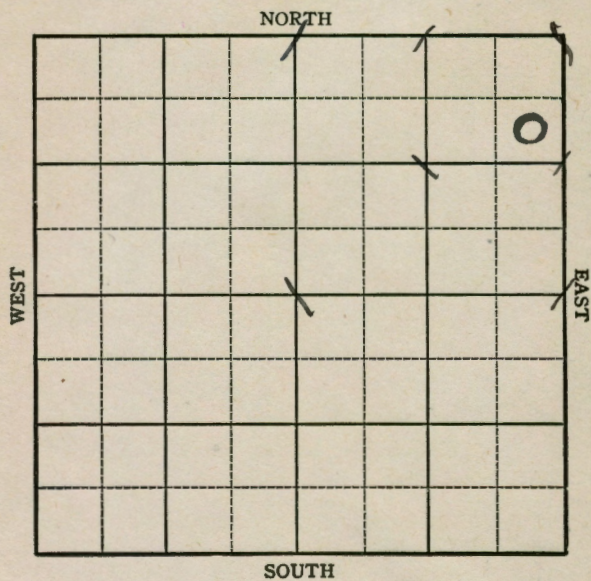


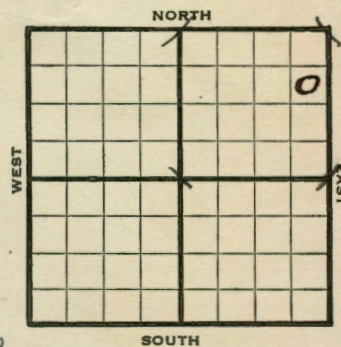
Norton

Section 31 Township 5 Range 21WWell No. #1 TurkCompany Phillips

Norton

Sec. 31 Twp. 5 R. 21WWell No. #1 Turk FarmPhillips Company

Wildcat

990 Ft. from N. Line         Ft. from S. Line330 Ft. from E. Line         Ft. from W. LineElev. 2313

1944

## REPORT

4/5 Location

4/12 Rotary

4/19 1410 SD

4/26 1850 SD

5/3 8" @ 1605  
TD 1850  
WOC

5/10 Drlg. 3490'

5/17 **Topeka 3265**  
**Lansing 3488**  
**Base Kansas City 3693**  
**Granite Wash 3741**  
**Total Depth 3795****ABANDONED**

KANSAS

Pool Name WildcatMap No. 132 Sec. 31 Twp. 5 R. 21WWell No. 1 TurkPhillips

Company

ABANDONED

Contractor

SE NE NE

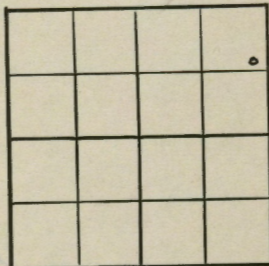
## SECTION PLAT

990 Ft. from N. Line

Ft. from S. Line

330 Ft. from E. Line

Ft. from W. Line

Norton County

Location

Rig up

Drilling and Remarks:

Spoke ka 3265Line 3488BXC 3693Granite Mark 3741

## RECORD

Cased in. ft.

Sand

Gas

Oil

Total Depth 3795

## PRODUCTION

1st 24 hrs. Nat.

1st 24 hrs. after shot

Gas Cu. Ft.

Dry Hole

Abandoned

Date

MAY 17 1944 19S. J. LEWIS Scout

Norton

Map No. 33 Sec. 31 Twp. 5 R. 21WWell No. 1 TurkPhillips

Company

FIRST REPORT

Contractor

SE NE NE

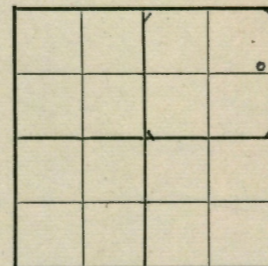
## SECTION PLAT

990 Ft. from N. Line

Ft. from S. Line

330 Ft. from E. Line

Ft. from W. Line

WildcatLocation X

Rig up

Drilling and Remarks:

## RECORD

Cased in. ft.

Sand

Gas

Oil

Total Depth

## PRODUCTION

1st 24 hrs. Nat.

1st 24 hrs. after shot

Gas Cu. Ft.

Dry Hole

Abandoned

Date

APR 5 1944 19S. J. LEWIS Scout