


Section 34 Township 5 Range 21 W
Well No. # 1 Sullivan
Company Saturn Drlg.

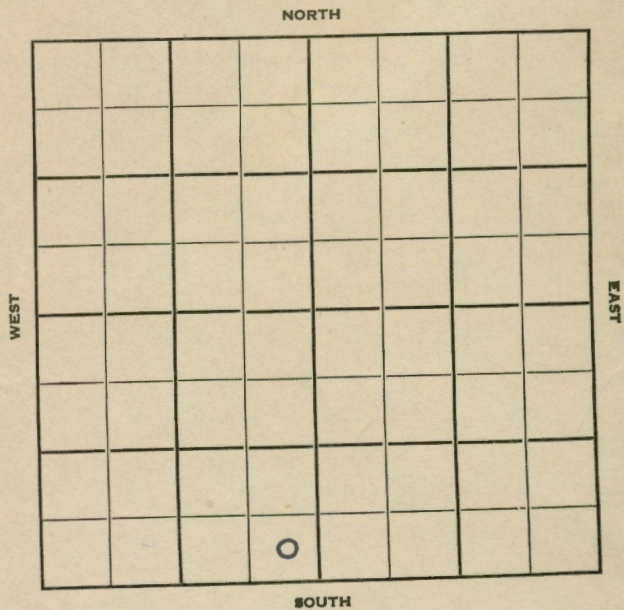


14

Sec. 34 Twp. 5 R. 21W ✓
Well No. #1 Sullivan Farm
Saturn Drlg. Company
Saturn Drlg. - Contr. Contractor

Wildcat
Ft. from N. Line
330' Ft. from S. Line
330' Ft. from E. Line
Ft. from W. Line

SE SE SW

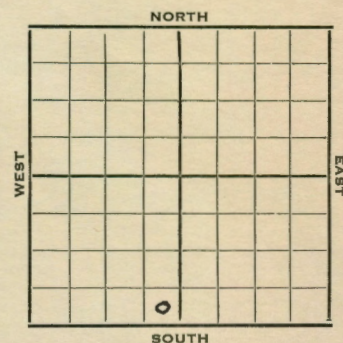

1952 **Elev. 2261'** REPORT

5/14 MIM
 5/21 8" @ 220
Anhy 1846
 Drlg. 3260'
 5/28 Spud 5-13-52
 D & A TD 3697' 8" @ 220'
Anhy 1846' **Heeb 3404'** **Tor. 3432'**
Lans. 3446'
 DST 3467-94 open 1 hr. rec 610' SW
 DST 3488-3502 open 3/4 hr. rec 850' mud
 & SW, 50' mud
Re-Arb 3675' **Regan 3680'** **Granite**
Wash 3684'
 DST 3664-97, open 1/2 hr, rec 10' mud
 TD 3697' D & A

ABANDONED

