


Section 35 Township 5 Range 21WWell No. #1 GriffinCompany Don Pratt

NORTH

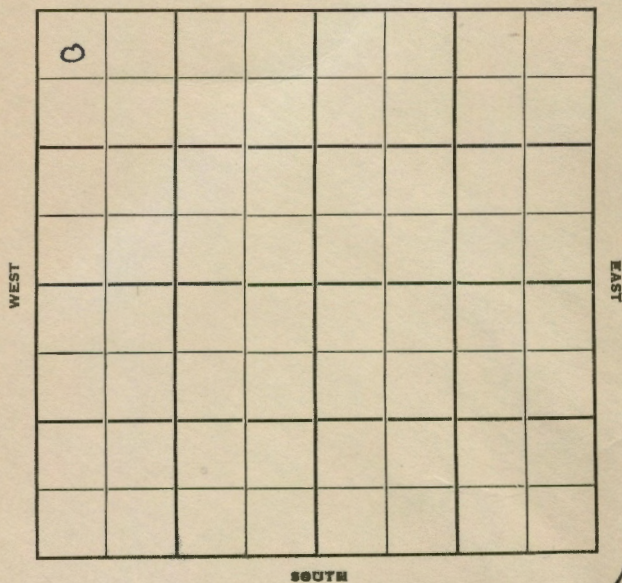

SOUTH

Sec. 35 Twp. 5 R. 21WWell No. #1 Griffin Farm

Don Pratt Company

Sauvage & Dunn Contractor

Semi Wildcat


330 Ft. from N. Line

Ft. from S. Line

Ft. from E. Line

330 Ft. from W. LineNW $\frac{1}{4}$ NW NW NW

NORTH

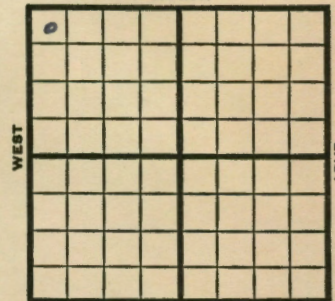

SOUTH

1952 Elev. 2273' REPORT

11/12 RUR

11/20 Anhy 1862' TD 3405' in Topeka
DST failed. Taking another DST in Topeka11/27 Heeb 3426, Dodge 3450, Lans 3468'
Drlg. 3519'12/3 Spud 11-11-52
D&A

TD 3728'

8" @ 183

Anhy 1862, Heeb 3426', Dodge 3450', Lans 3468

DST 3524-46, opn 1 hr., rec. 190' wtr., 1280#

B KC 3659

DST 3700-07, opn 3/4 hrs., rec. 4' mud 0#

Sd 3704, Gr. Wash 3707

TD 3728

D&A

ABANDONED

County	Norton		State	Kansas	
Sec.	35	(Blk. Twp.)	5	(Sur. Rge.)	21W Map No.
Operator	Don Pratt				
Well No.	1	Farm	Griffin		
Elev.	2273	Location	NW NW NW		

330 Ft. From N Line NW
330 Ft. From W Line Quarter

Spudding Date 11-11-52

Drig. Data D & A TD 3728

8" @ 183 Anhy. 1862 Heeb. 3426
Dodge 3450 Lans. 3468 DST 3524-46
open 1 hr. Rec. 190' wtr. 1280#
B KC 3659 DST 3700-07 open 3/4 hr.
Rec. 4' mud O# Sd. 3704 Gr. wash 3707
TD 3728

D & A

J. G. McGEHEE

County	Norton		State	Kansas	
Sec.	35	(Blk.) (Twp.)	5	(Sur.) (Rge.)	21W Map No.
Operator	Don Pratt				
Well No.	1	Farm	Griffin		
Elev.	Location		NW NW NW		

330 Ft. From N Line NW
330 Ft. From W Line Quarter

Sauvage & Dunn - Contr.

Spudding DateDrig. Data

Semi Wildcat

R U R

J. G. McGEHEE