


KANSAS

FORM 51 IOM 12-46 PETROL

Section 36 Township 5 Range 21-WWell No. #3 KitzkeCompany Cities Service
Hansen Pool

NORTH

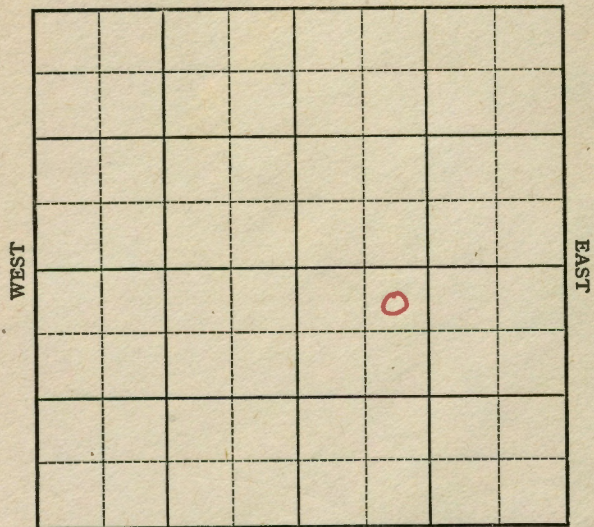

SOUTH

EAST

10

5M 12-46 PETROL

KANSAS

Sec. 36 Twp. 5 R. 21WWell No. #3 Kitzke Farm

Cities Service


Hansen pool

Company

330 Ft. from N. Line

Ft. from S. Line

Ft. from E. Line

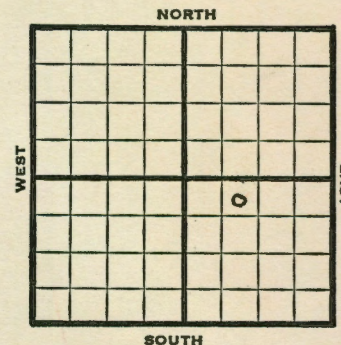990 Ft. from W. Line

NE NW SE

1947 **Elev. 2211'** REPORT

6/11 Location

6/24 Reagan 3624-37

T.D.

5" @ 3634

RUST

7/1 Quartzite 3638'

Granite 3640'

TD 3641'

7/8 47 shots 3628-39
Pump 32 fluid in 6 hrs 3% oil7-16 Pump 36 bbls oil & 12%
Water in 6 hrs.

7/22 "

7/29 "

8/6 "

8/13 "

8/20 "

8/27 Lans. 3395'
Quartzite 3638'
Granite 3640'
Perf 3628-39
2000 Acid**OVER**

(Continued)

1947

8/27 Pump 35 oil & 22 W Pot
Gr. 26°
Total Depth 3641'

COMPLETED

Map No. 133 Sec. 36 Twp. 5 R. 21WWell No. 3 Kitzke

Cities Service Company

COMPLETE

Contractor

NE NW SE

E1, 2211
SECTION PLAT330 Ft. from N. Line

Ft. from S. Line

Ft. from E. Line

990 Ft. from W. Line

Norton County

Location

Rig up

Drilling and Remarks:

Lease 3270Quartzite 3638Granite 3640Ref 3625-882000 cu. ft.Pump 35 oil + 22.1026.2 G.

RECORD

Cased in, ft.

Sand

Gas

Oil

Total Depth 3641

PRODUCTION

1st 24 hrs. Nat.

1st 24 hrs. after shot

Gas Cu. Ft.

Dry Hole

Abandoned

Date

AUG 27 1947 19 S. J. LEWIS Scout

Map No. Sec. 36 Twp. 5 R. 21WWell No. 3 Kitzke

Cities Service Company

FIRST REPORT

Contractor

NE NW SE

SECTION PLAT

330 Ft. from N. Line

Ft. from S. Line

Ft. from E. Line

990 Ft. from W. Line

Norton County

Location X

Rig up

Drilling and Remarks:

RECORD

Cased in, ft.

Sand

Gas

Oil

Total Depth

PRODUCTION

1st 24 hrs. Nat.

1st 24 hrs. after shot

Gas Cu. Ft.

Dry Hole

Abandoned

Date

11 1947 19 S. J. LEWIS Scout