


SECTION 23 TOWNSHIP 5S RANGE 21W

WELL NO. #2 Baird

COMPANY Jocelyn-Varn

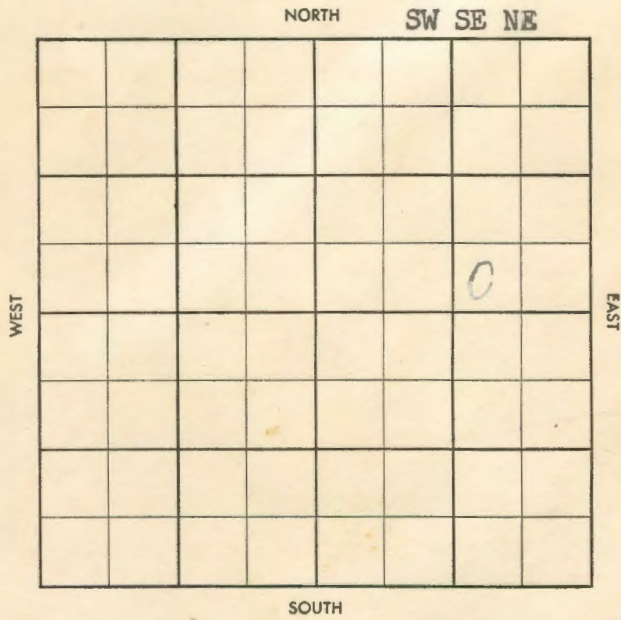

8

