

Norton


Section 6 Township 5 Range 22-W

Well No. #1 Business Men Association

Company Cities Service Oil

Wildcat

NORTH

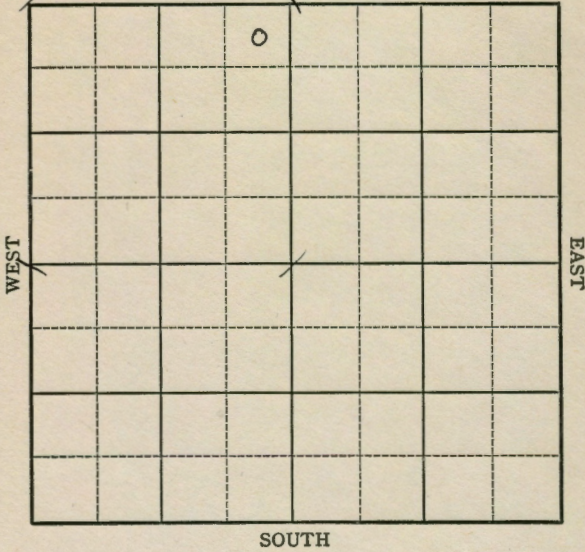

KANSAS Norton

Sec. 6 Twp. 5 R. 22-W

Well No. #1 Business Men Association Farm

Cities Service Oil

Company

(Wildcat)


330 Ft. from N. Line

Ft. from S. Line

330 Ft. from E. Line

Ft. from W. Line

Elev. 2264'

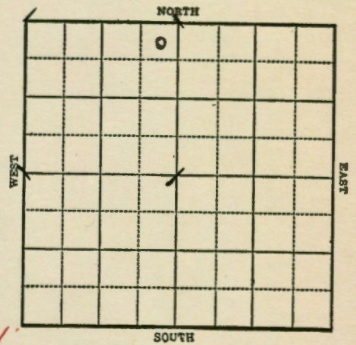

1942

R E P O R T

10/7

Rotary.

10/14

8" @ 215

Drig. 1500'

10/21

Drig 3070

10/28

Topeka 3160

Lans. 3404

BKC 3580

Congl. 3705

Granite Wash 3723

Granite 3772

No shows

T.D. 3775'

ABANDONED

Map No. 134 Sec. 6 Twp. 5Well No. 1 Business Men's Assn.

Cities Service Oil

Company

ABANDONED

Contractor

NE NW

330 Ft. from N. Line

Ft. from S. Line


330

Ft. from E. Line

Ft. from W. Line

WILDCAT

SECTION PLAT

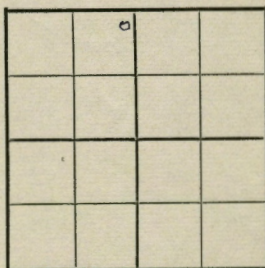

Location

Rig up

Drilling and Remarks:

*Topo ka 3160**Lans 3404**BTC 3580**Congl. 3705**Granite Wash 3723**Granite 3772**House*

RECORD

Cased in., ft.

Sand

Gas

Oil

Total Depth 3725

PRODUCTION

1st 24 hrs. Nat.

1st 24 hrs. after shot

Gas Cu. Ft.

Dry Hole

Abandoned

Date

OCT 28 1942 19

S. J. LEWIS

Scout

Map No. 134 Sec. 6 Twp. 5 R. 22WWell No. 1 Business Men Association

Cities Service Oil

Company

FIRST REPORT

Contractor

NE NW

330 Ft. from N. Line


Ft. from S. Line

330 Ft. from E. Line

Ft. from W. Line

WILDCAT

SECTION PLAT

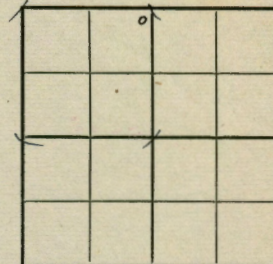

Location

Rig up

Drilling and Remarks:

Rotary

RECORD

Cased in., ft.

Sand

Gas

Oil

Total Depth

PRODUCTION

1st 24 hrs. Nat.

1st 24 hrs. after shot

Gas Cu. Ft.

Dry Hole

Abandoned

Date

OCT 7 1942 19

S. J. LEWIS Scout