


Section 10 Township 5 Range 22WWell No. #1 VossCompany Harry Gore

NORTH

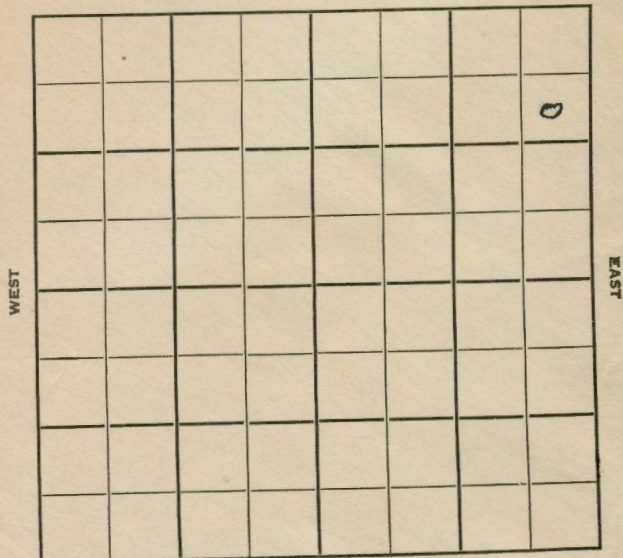

SOUTH


Sec. 10 Twp. 5 R. 22 WWell No. # 1 Voss FarmHarry Gore CompanyEmpire ContractorWildcat990 Ft. from N. Line

Ft. from S. Line

330 Ft. from E. Line

Ft. from W. Line

NORTH

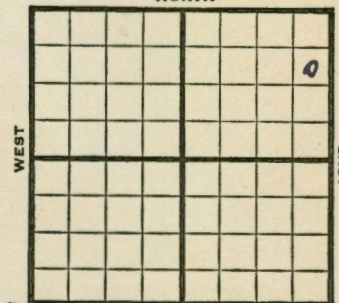

SE NE NE

Phillips & Skelly & C.S.O. support

1952 Elev. 2126' REPORT

5/28 Spud 5-23-52
8" @ 199

Drlg. 2118'

6/11 Spud 5-23-52
D & A TD 3605' 8" @ 199

Top. 3056' Heeb 3247' Br. lime 3274'

Lans. 3291'

DST 3276-3334' open 1 hr, rec 120'

mud & tr. oil

DST 3342-79 open 35 min. rec 795' muddy
SW

B KC 3477' Sand 3533-40'

DST 3519-37 open 1/2 hr. rec 43' muddy

GCW & scum oil Arb. 3540'


DST 3542-57 open 1/2 hr. rec 930' GCSW

Regan 3560' Granite wash 3585'

TD 3605' D & A

ABANDONED

County Norton State Kansas
 Sec. 10 (Blk. 5) (Sur. 22W) Map No.
 Operator Harry Gore
 Well No. 1 Farm Voss
 Elev. 2126 Location SE NE NE

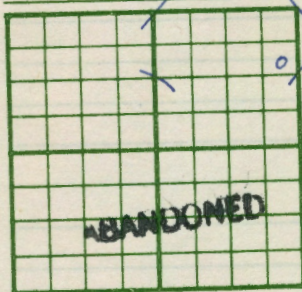

990 Ft. From N Line NE
 330 Ft. From E Line Quarter

1st. Report

Completion JUN 11 1952

Remarks Wildcat

Empire Drlg. - Contr.

Spudding Date 5-23-52

Drlg. Data D & A TD 3605

8" @ 199 Top. 3056 Heeb. 3247

Br. lime 3274 Lens. 3291 DST 3276-3334

Open 1 hr/ Rec. 120' mud & tr. oil

DST 3342-79 open 35 min. Rec. 795'

muddy sw B KC 3477 Sand 3533-40

DST 3519-37 open 1/2 hr. Rec. 43' muddy

gcw & scum oil Arb. 3540 DST 3542-57

open 1/2 hr. Rec. 930' gcsw Regan 3560

Granite wash 3585' TD 3605

D & A


J. G. McGEHEE

County Norton State Kansas
 Sec. 10 (Blk. 5) (Sur. 22W) Map No.

Operator Harry Gore

Well No. 1 Farm Voss

Elev. Location SE NE NE

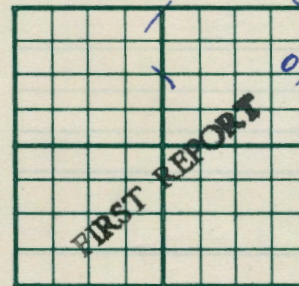

990 Ft. From N Line NE

330 Ft. From E Line Quarter

1st. Report MAY 28 1952

Completion

Remarks Phillips & Skelly
& C.S.O.-Support

Empire - Contr.

Spudding Date 5-23-52

Drlg. Data Wildcat

8" @ 199 Drlg. 2118

J. G. McGEHEE