


Norton

KANSAS

SECTION 13 TOWNSHIP 5S RANGE 22W

WELL NO. #2 Bullock

COMPANY Bennett & Roberts Inc.

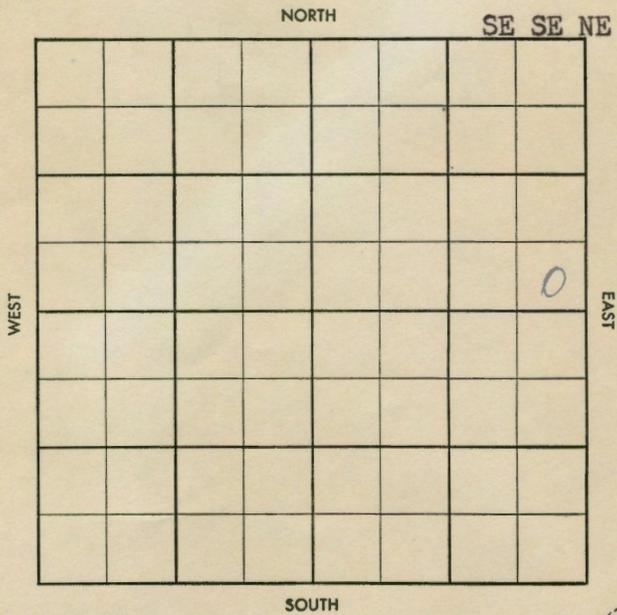

Top Pool
 Co. Tools
 Densmore

S-513-B

County Norton Elev. 2176 DF
 Sec. 13 Twp. 5 Rge. 22W
 Company Bennett & Roberts Inc.
 Farm Name Bullock No. 2

TOPS	DEPTH	LOG	DATUM	Loc. in Sec.
Anh. <u>1770</u>				<u>SE SE NE</u>
Tr.				
H.	<u>3307</u>			
Tr.	<u>3332</u>			
Dg.				
B.L.				
L.	<u>3353</u>			
K.C.				
B.K.C.	<u>3539</u>			
Ce.				
C.				
M.				
M.				
K.				
Mz.				
Mq.				
V.				
S.				
S.				
A.				
R.				
Pf.				
G.	<u>wash 3598</u>			
T.D.	<u>3616</u>			

ABANDONED
 SEP 3 '58

Date Comm. 8/21/58
8" @ 212 w/125, Drlg 2140 SEP 3 '58 DST
3336-60 60" 7'M SPK soil BHP345
DST 3393-3421 1hr 8'M BHP550/20"
ran log

D6A

Top Pool
 Co. Tools
 Densmore

S-513-B

County Norton Elev. _____
 Sec. 13 Twp. 5 Rge. 22W
 Company Bennett & Roberts Inc.
 Farm Name Bullock No. 2

TOPS	DEPTH	LOG	DATUM	Loc. in Sec.
Anh. <u>1770</u>				<u>SE SE NE</u>
Tr.				
H.				
Tr.				
Dg.				
B.L.				
L.				
K.C.				
B.K.C.				
Ce.				
C.				
M.				
M.				
K.				
Mz.				
Mq.				
V.				
S.				
S.				
A.				
R.				
Pf.				
G.				
T.D.				

FIRST REPORT
 AUG 27 '58

Date Comm. 8/21/58
8" @ 212 w/125, Drlg 2140