


Section 12 Township 5 Range 22W
 Well No. 1 Weogard
 Company Jones, Shelburne & Farmer

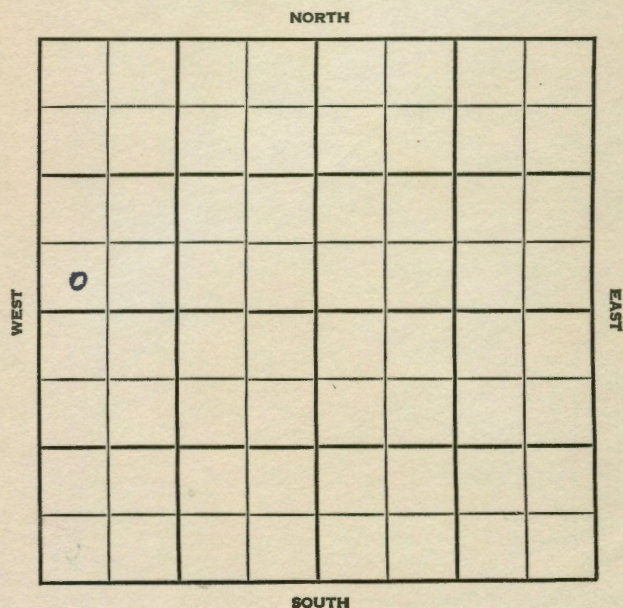

SEC.	12	TWP.	5	R.	22 W
WELL NO. # 1 Weogard FARM					
COMPANY Jones, Shelburne & Farmer					
CONTRACTOR Co. tools Wildcat					
Ft. from N. Line					
330 Ft. from S. Line					
Ft. from E. Line					
330 Ft. from W. Line					
SW SW NW					

WEST

NORTH

SOUTH

ELEVATION	REPORT
1955	2095'
1/5	MIR
1/19	Spud 1-3-55 D & A TD 3552' 8" @ 166' Anhy 1695' Heeb 3226' Dodge 3248' Lans 3267' DST 3421'-41' opn 1/2 hr, rec 10' Mud, 640# DST 3505'-10' opn 1/2 hr, rec 3' Mud 0# Gorham 3511' DST 3511'-20' opn 1/2 hr rec 3' Mud 0# Reagan 3522' DST 3522'-25' opn 1 hr, rec 350' hgo 10' oily wtr. 300# s.w. 930# TD 3552' D & A

ABANDONED

MIR

FABEN GILSTRAP

D & A

FABEN GILSTRAP