


SEC. 23 TWP. 5 R. 22W ✓
 WELL NO. 1 McKinley FARM
 COMPANY Trans-Era.
 Contractor Nate Appleman

Wildcat

~~330~~ Ft. from N. Line
 990 Ft. from S. Line
 330 Ft. from E. Line
 Ft. from W. Line

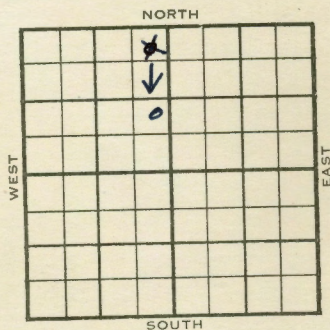


NE ^{SE} NW CSO-DHM

1954 ELEVATION 2225' REPORT

6/18 Spdg. 6-21-54
 8" @ 160
 WOC
 6/30 Heeb 3418', Lans 3462'
 Drlg. 3525'
 7/7 Spud 6-21-54
 D&A
 TD 3790'
 8" @ 160'
 Heeb 3418', Lans 3462', B KC 3650',
 Cong 3730', Arb. 3758'
 TD 3790'
 D&A

ABANDONED

Section 23 Township 5 Range 22 W
 Well No. # 1 McKinley
 Company Trans-Era
 Nate Appleman

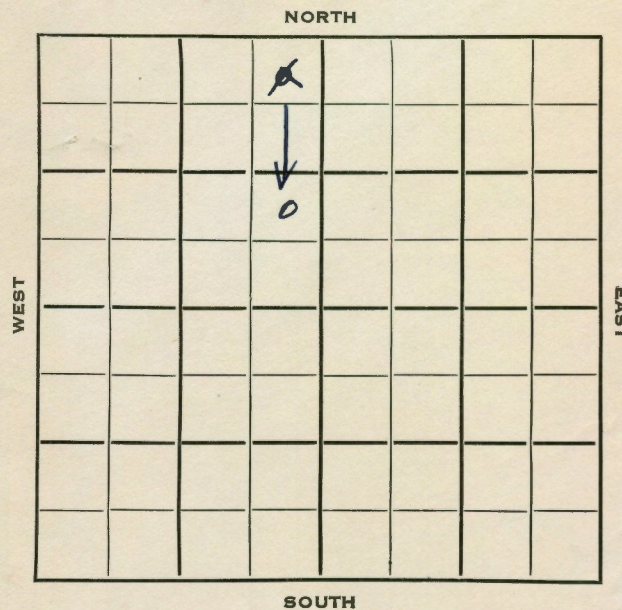

6

County Norton State Kansas
 Sec. 23 (Blk. 5 (Sur. 22W Map No.
 Operator Trans-Era Pet.
 Well No. 1 Farm McKinley
 Elev. 2225 Location NE SE NW



990 Ft. From S Line NW
 330 Ft. From E Line Quarter

1st. Report
 Completion JUL 7 1954
 Remarks Wildcat


Spudding Date 6-21-54

Drig. Data D & A TD 3790
 8" @ 160 Heeb. 3418 Lans. 3462
 B KC 3650 Cong. 3730 Arb. 3758
 TD 3790

D & A

J. G. McGEHEE

County Norton State Kansas
 Sec. 23 (Blk. 5 (Sur. 22W Map No.
 Operator Edo Appleman
 Well No. 1 Farm McKinley
 Elev. Location NE NE NW

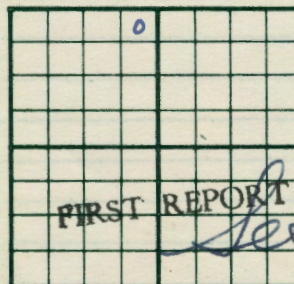

330 Ft. From N Line NW

330 Ft. From E Line Quarter

1st. Report JUN 7 1954

Completion

Remarks CSO - DHM

Spudding Date 6-21-54

Wildcat

Drig. Data
 8" @ 160 WOC

J. G. McGEHEE

Kansas

Map No. _____ Sec. 23 Twp. 5 R. 22WWell No. 1 McKinley

Trans-Era

Company

CORRECTION

Contractor


NE SE NW

SECTION PLAT

_____ Ft. from N. Line

990 Ft. from S. Line330 Ft. from E. Line

_____ Ft. from W. Line

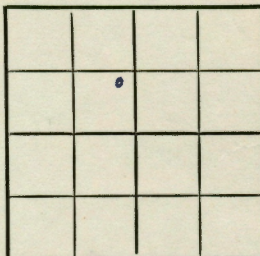

Norton County

Location _____

Rig up _____

Drilling and Remarks:

Reported
Nate Appleman
#1 McKinley
NE NE NW

RECORD

Cased _____ in., _____ ft.

Sand _____

Gas _____

Oil _____

Total Depth _____

PRODUCTION

1st 24 hrs. Nat. _____

1st 24 hrs. after shot _____

Gas _____ Cu. Ft.

Dry Hole _____

Abandoned _____

Date

JUN 30 1954 19J. G. McGEHEE

Scout