

KANSAS


FORM 51 5M 4-41 PETROL

Norton

Section 22 Township 5 Range 23-WWell No. #1 BelpCompany Derby, Crow & Bay

NORTH

Wildcat

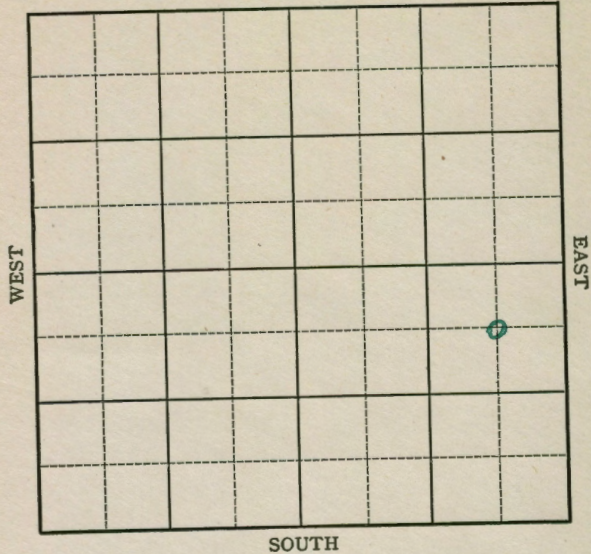

9

FORM 252-A
5M 10-41 PETROL

KANSAS


Norton

Sec. 22 Twp. 5 R. 23-WWell No. #1 Belp FarmDerby, Crow & Bay Company

(Wildcat)

660 Ft. from N. Line Ft. from S. Line660 Ft. from E. Line Ft. from W. Line

Elev. 2280

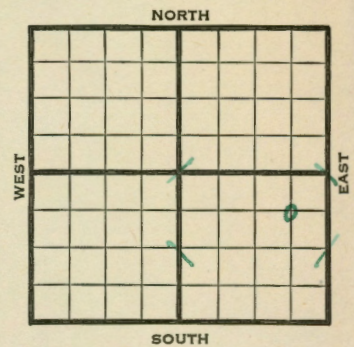

1942

REPORT

6/17 8" - 205' Drlg. 2416'

6/24 Anhy. 1900' Topeka 3218'

Lans. 3449' S.S.O. 3536-38'

Drlg. 3556'

6/1 Arb. 3822' T.D. 3897'

7/8 Arb. 3822'

T.D. 3897'

No shows.

ABANDONED

KANSAS

Norton

Map No. 134 Sec. 22 Twp. 5 R. 23WWell No. 1 Belp

Derby, Crow & Bay Company

ABANDONED Contractor

C NE SE


SECTION PLAT

660 Ft. from N. Line

Ft. from S. Line

660 Ft. from E. Line

Ft. from W. Line

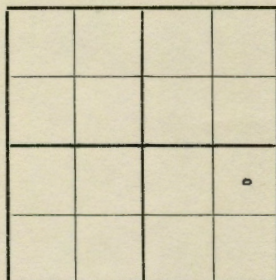

WILDCAT

Location

Rig up

Drilling and Remarks:

Cr 83522No show

RECORD

Cased in, ft.

Sand

Gas

Oil

Total Depth 3897

PRODUCTION

1st 24 hrs. Nat.

1st 24 hrs. after shot

Gas Cu. Ft.

Dry Hole

Abandoned

Date

JUL 8 1942 19 S. J. LEWIS Scout

Norton

KANSAS

Map No. 134 Sec. 22 Twp. 5 R. 23WWell No. 1 Belp

Derby, Crow & Bay Company

FIRST REPORT Contractor

C NE SE


SECTION PLAT

660 Ft. from N. Line

Ft. from S. Line

660 Ft. from E. Line

Ft. from W. Line

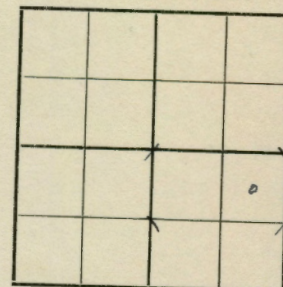

WILDCAT

Location

Rig up

Drilling and Remarks:

8" - 205'Drlg. 2416'

RECORD

Cased in, ft.

Sand

Gas

Oil

Total Depth

PRODUCTION

1st 24 hrs. Nat.

1st 24 hrs. after shot

Gas Cu. Ft.

Dry Hole

Abandoned

Date

JUN 17 1942 19 S. J. LEWIS Scout