


Section 26 Township 5 Range 24WWell No. #1 DwyerCompany Jones, Shelborne & Farmer

NORTH

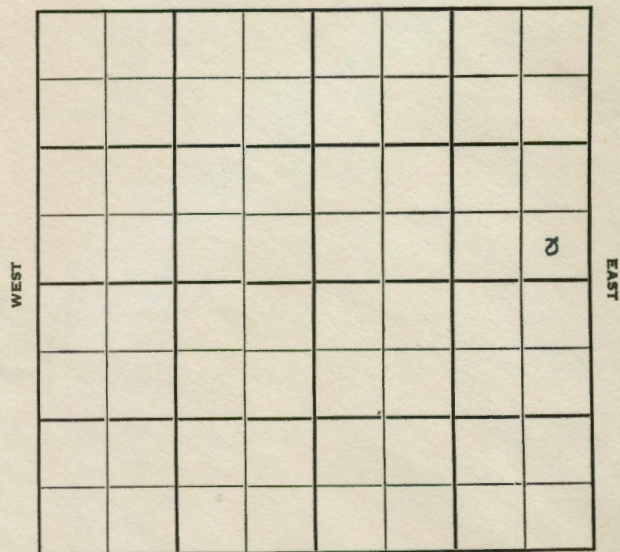

SOUTH

8

Sec. 26 Twp. 5 R. 24WWell No. #1 Dwyer FarmJones, Shelborne & Farmer Company

J S F

Wildcat

Contractor

Ft. from N. Line


330 Ft. from S. Line330 Ft. from E. Line

Ft. from W. Line

SE SE NE

Derby DHM

NORTH

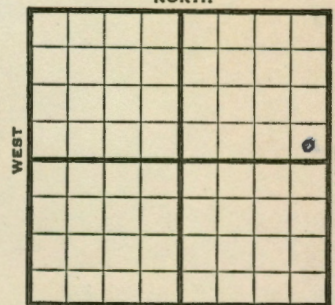

SOUTH

1952

Elev. 2366'

REPORT

1/2

Spud 12-27-51

8" @ 160'

Anhy 1990'

Drlg. 2220'

1/16

Spud 12-27-51

D&A TD 3970' 8" @ 160'

Anhy 1990 Top. 3302

Heeb. 3502 Tor. 3526

Lans. 3540

DST 3554-76 open 1 hr. rec. 60'

wtr. & mud & SSO

DST 3575-3620 open 1 hr. rec. 70'

mud & wtr.

B KC 3732 Arb. 3920

TD 3970

D&A

ABANDONED

$$\begin{array}{r} 3920 \\ 2366 \\ \hline 1554 \end{array}$$

